


T.16S.R.4E.W.M.

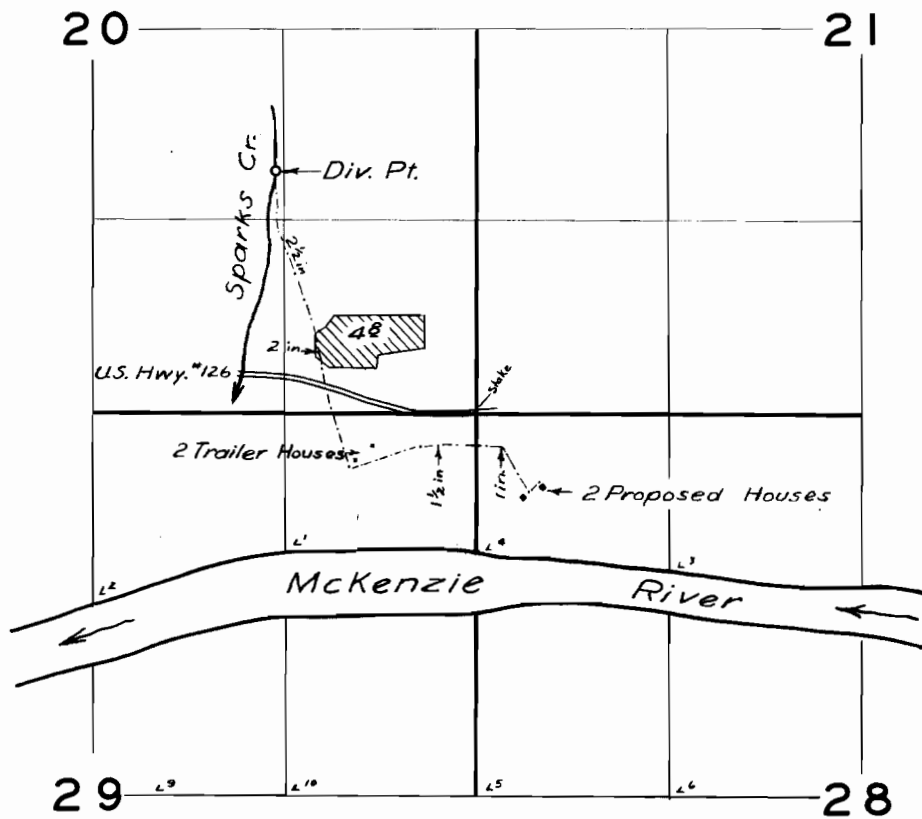

**FINAL PROOF SURVEY**

UNDER

Application No. 25826 Permit No. 20290

IN NAME OF

W.E. Schwering & P.C. McGovern

Surveyed July 1 1957, by M. Bish