


T. 17S. R. 10W. W.M.

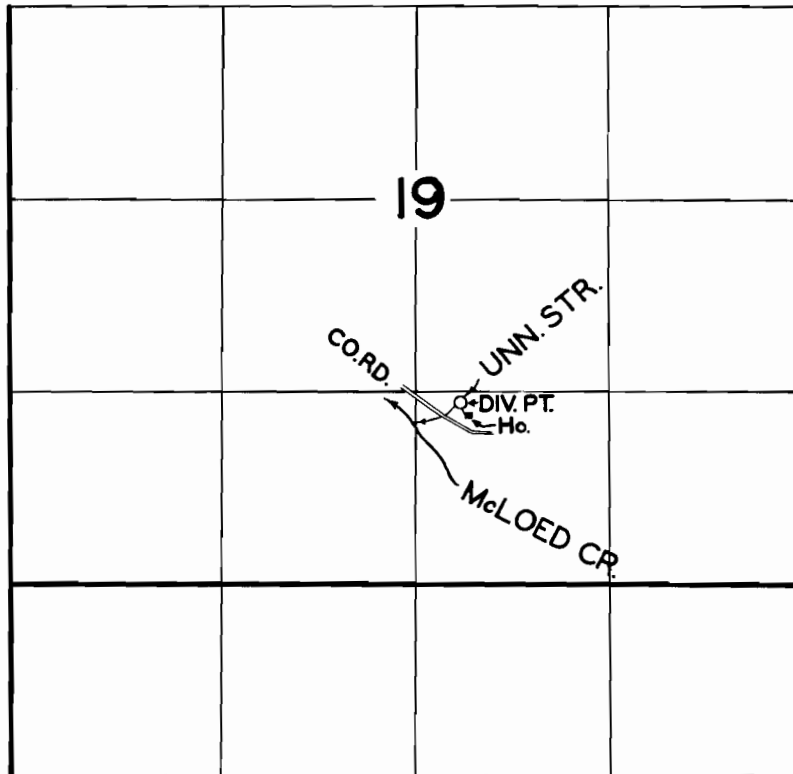

FINAL PROOF SURVEY
UNDER

Application No. 26299 Permit No. 20643
IN NAME OF

Estate of Lizzie Jackson

Surveyed MAY 25, 1957, by *[Signature]*