


T.16S. R.25E.W.M.

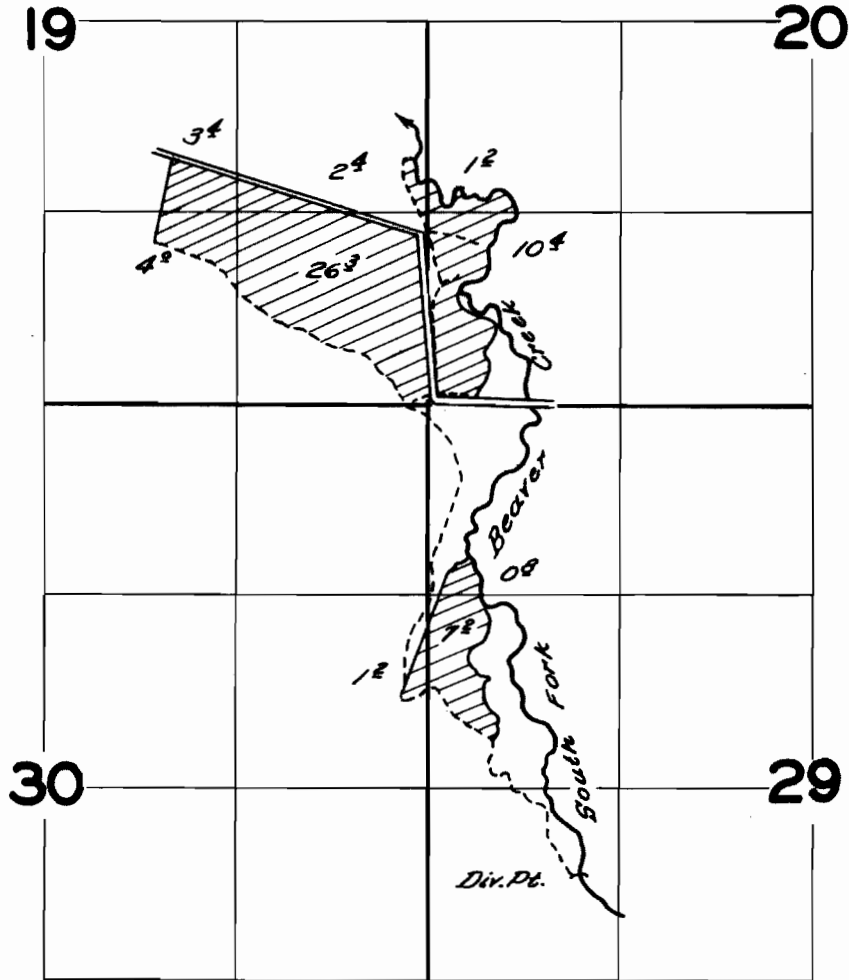

FINAL PROOF SURVEY
UNDER

Application No. 26672 Permit No. 20885
IN NAME OF

J. H. Schwanzer

Surveyed Sept. 25 1957, by C. D. Burtis