


T.7S. R.45E. W.M.

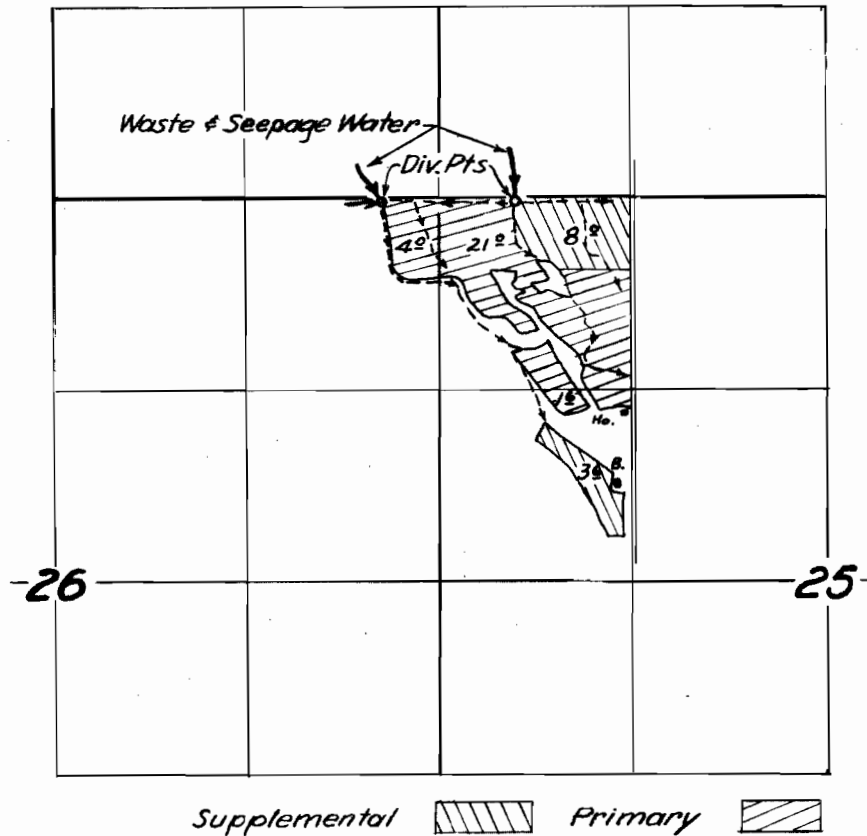

FINAL PROOF SURVEY
UNDER

Application No. 26686.. Permit No. 20893..
IN NAME OF

Ardith E. Pickler

Surveyed 17 Oct. 1956 by *Tom Bish*