


# T.6S.R.3W.W.M.

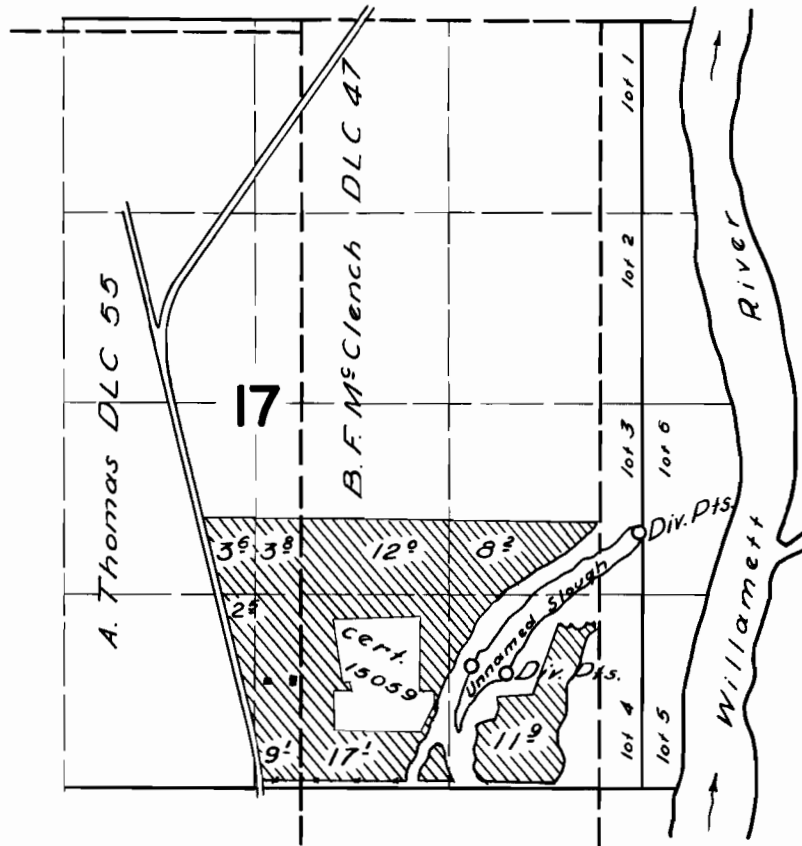

## FINAL PROOF SURVEY

UNDER

Application No. 25756 Permit No. 20976

IN NAME OF

Surveyed 23 July 1957, by [Signature]