


T.15S.R.5W.W.M.

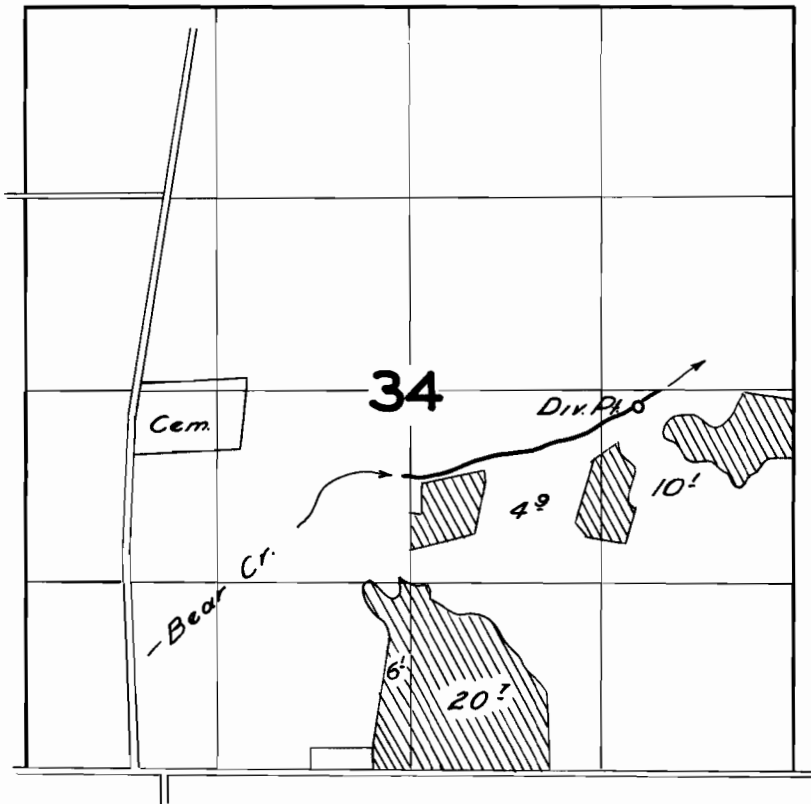

FINAL PROOF SURVEY

UNDER

Application No. 26985 Permit No. 21196

IN NAME OF

JOHN V. CAROTHERS

Surveyed 18 Apr. 1957, by *C. H. Hilday*