


T.6S.R.7W.W.M.

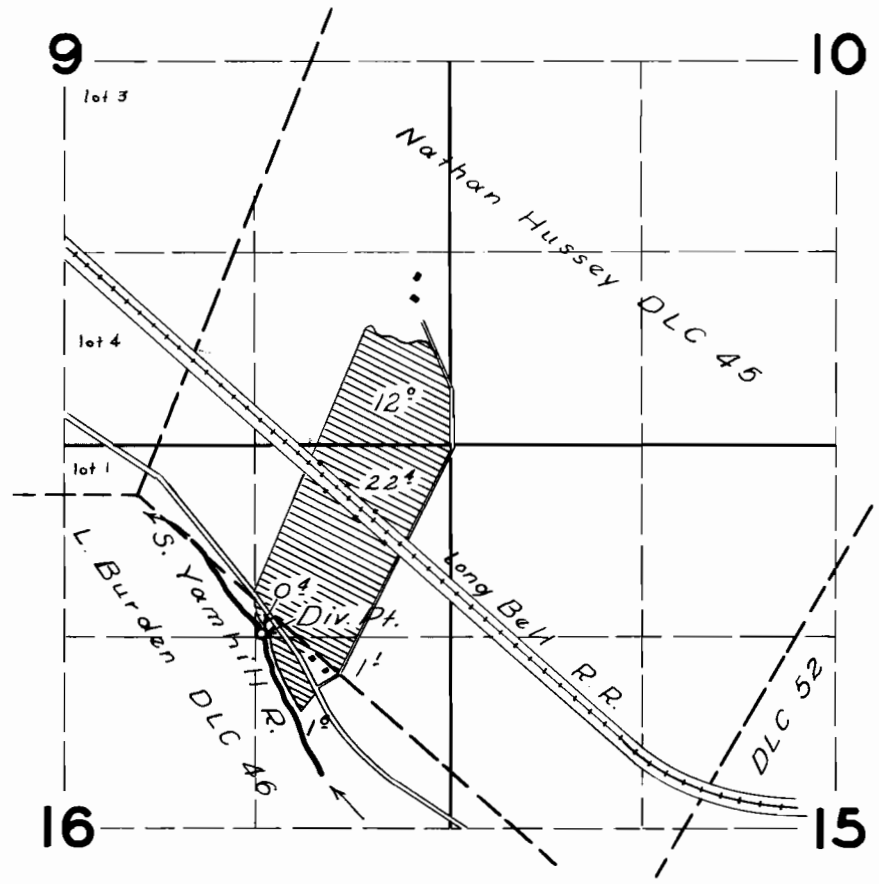

**FINAL PROOF SURVEY**  
UNDER

Application No. 27193 Permit No. 21385  
IN NAME OF

JOHN BREEDEN

Surveyed 26 July 1957, by [Signature]