


T.17S.R.1E.W.M.

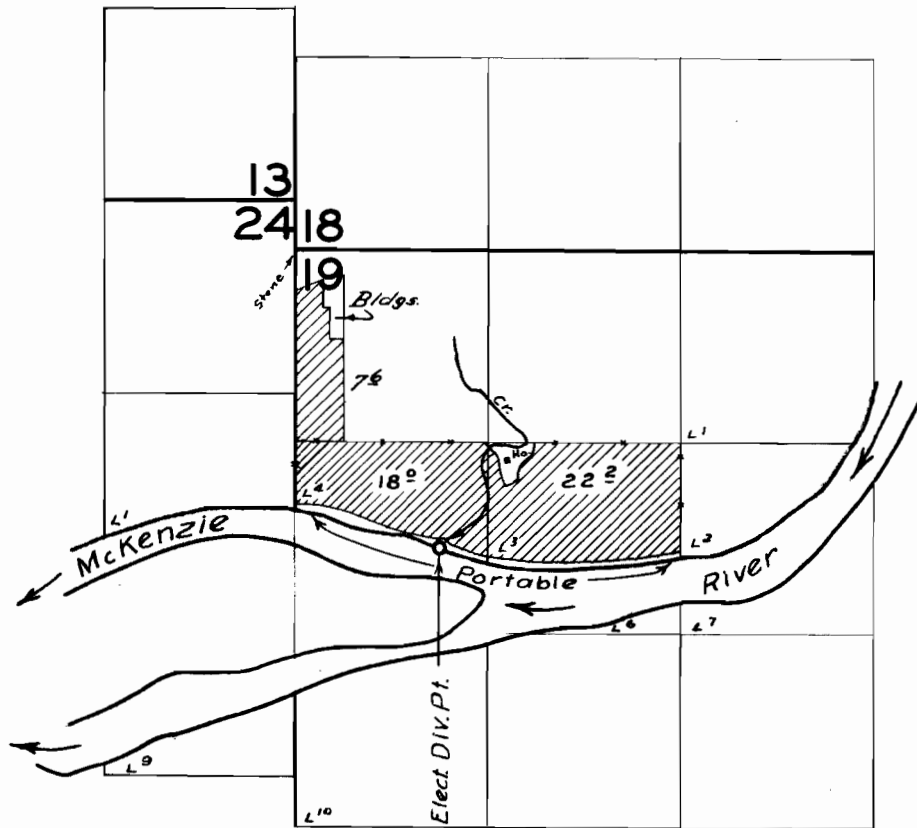

FINAL PROOF SURVEY UNDER

Application No. 27154... Permit No. 21414...
IN NAME OF

.....Koozer Bros. by Lloyd Koozer

Surveyed June 21 1957, by *M. Bish*.....