


T.18S.R.5 W.W.M.

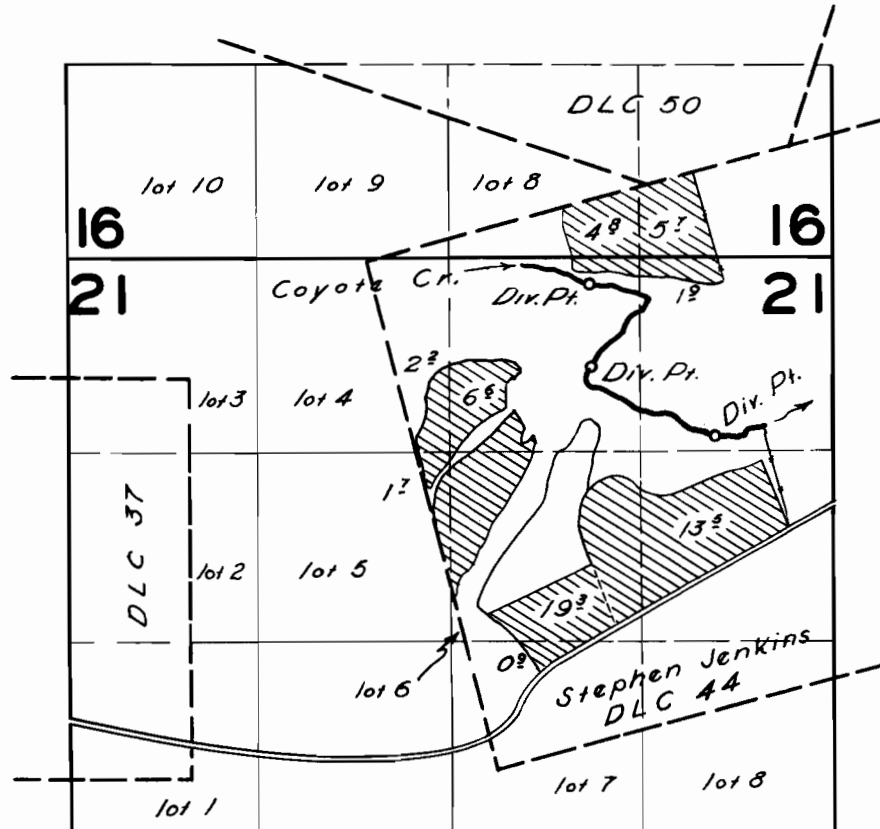

**FINAL PROOF SURVEY**  
UNDER

Application No. 25768 Permit No. 21506  
IN NAME OF

PAULA M. & WM. F. KITTEL

Surveyed 7 May 1957, by [Signature]