


T.28S.R.7W.W.M.

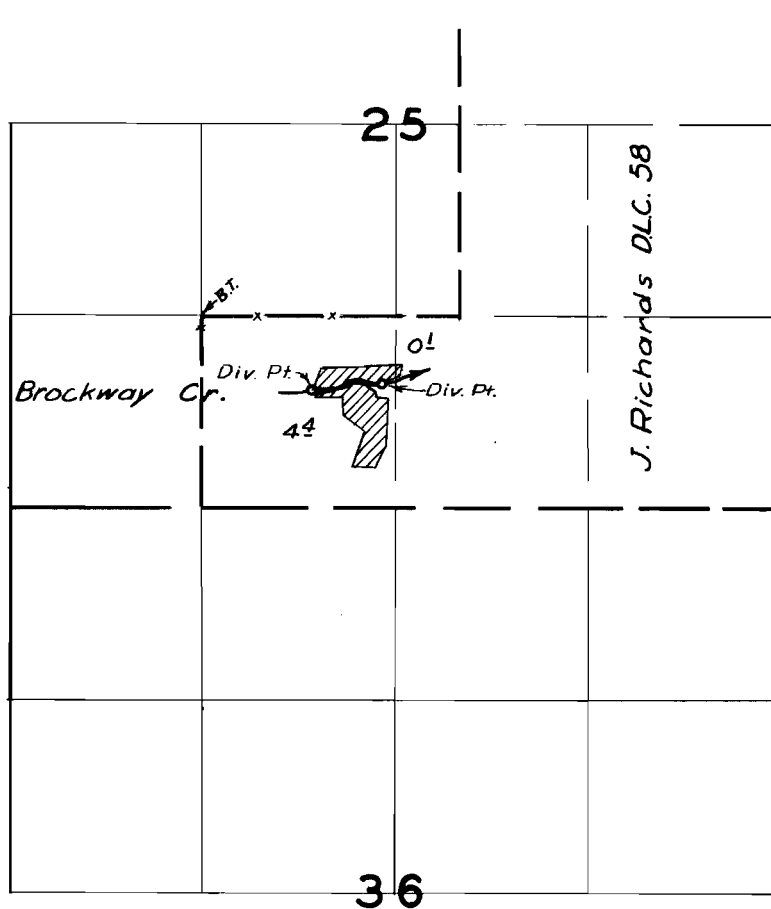

FINAL PROOF SURVEY
UNDER

Application No. 27367 Permit No. 21545
IN NAME OF

Henry C. Schattenkerk

Surveyed July 22 1957, by Tom Bish