


T.7S.R.5W.W.M.

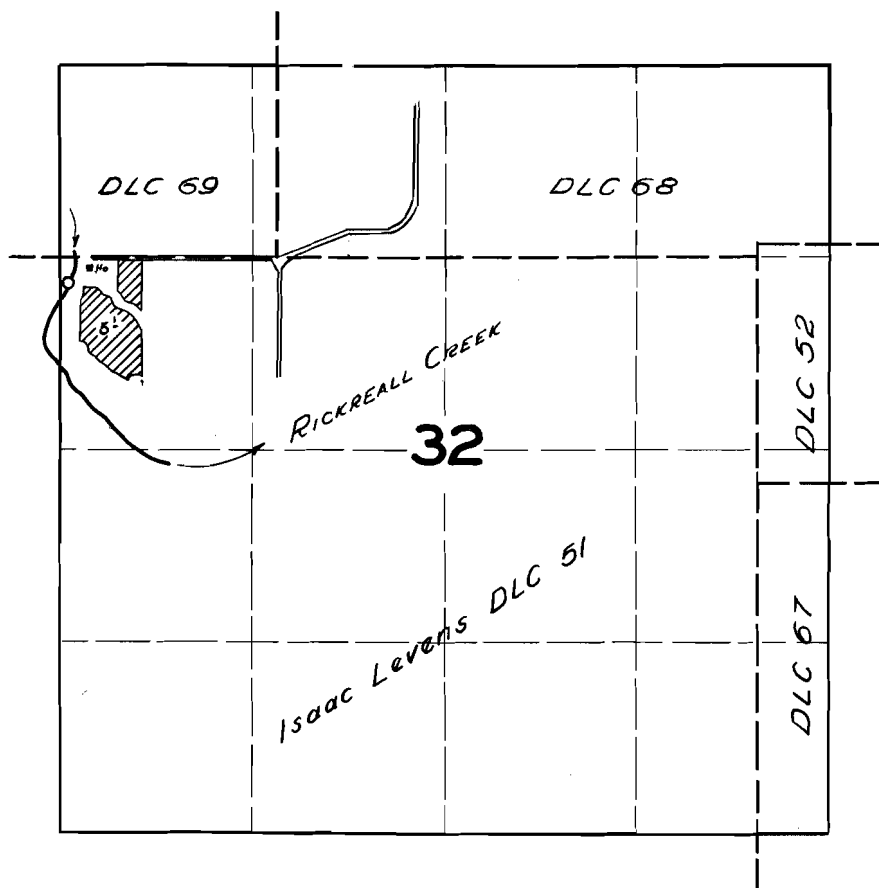

FINAL PROOF SURVEY

UNDER

Application No. 27538 Permit No. 21727

IN NAME OF

CARL & VIOLA INEZ MAY

Surveyed 3 April 1957, by [Signature]