


T. IN. R. IOW. W. M.

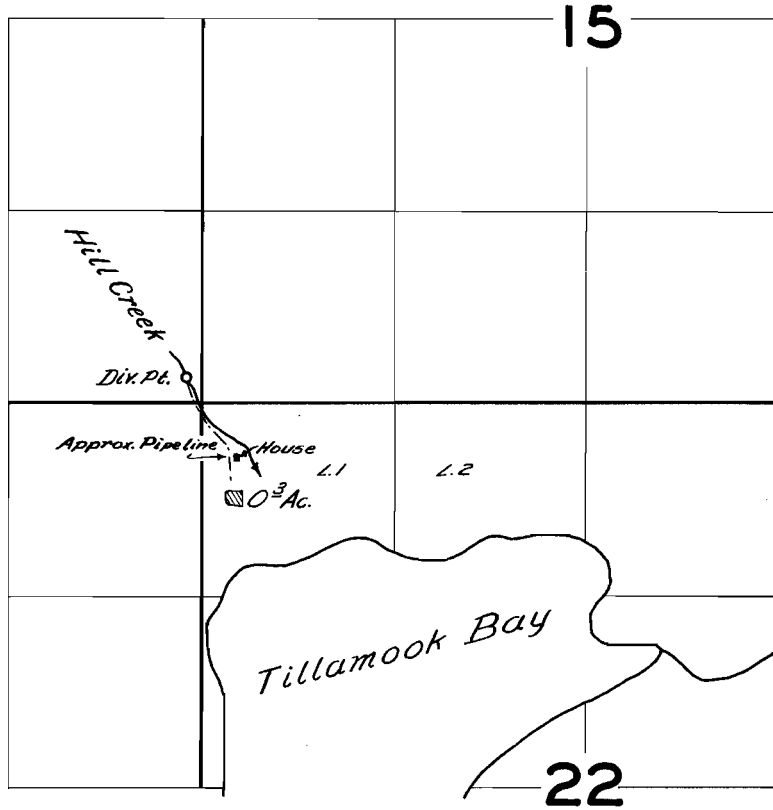

FINAL PROOF SURVEY
UNDER

Application No. *27634* Permit No. *21832*
IN NAME OF

..... *George D. Wolf*

Surveyed *Sept. 13* 1957, by *C. O. Barber*