


T.9S.R.4W.W.M.

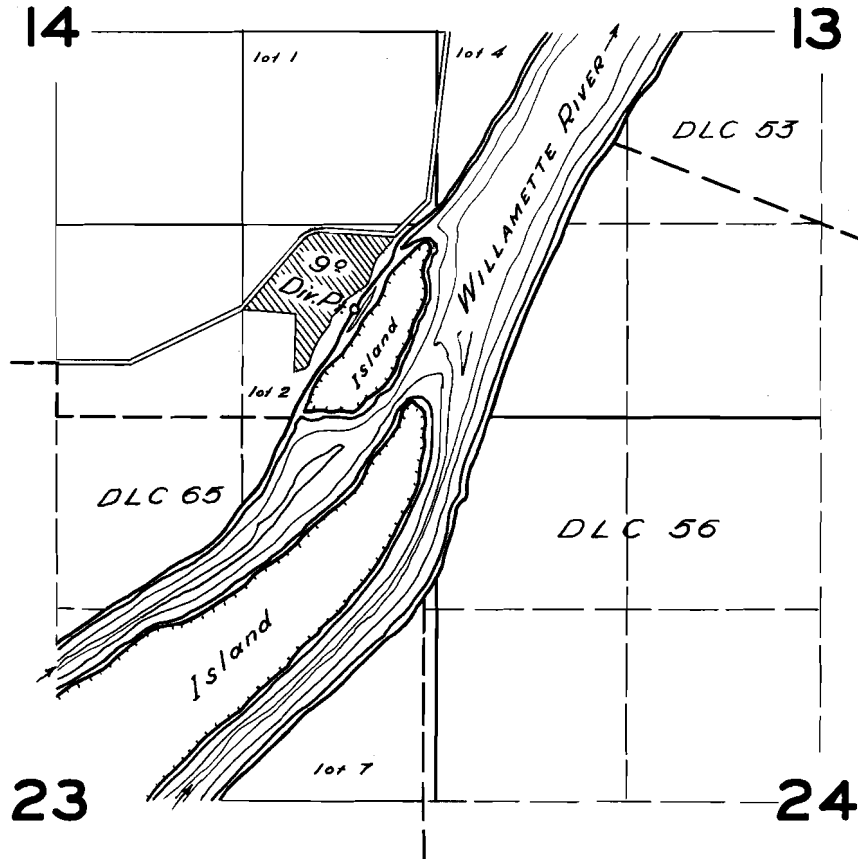

FINAL PROOF SURVEY
UNDER

Application No. 27782 Permit No. 21871
IN NAME OF

CHARLIE J. GREEN

Surveyed 31 July 1957, by [Signature]