


T.13S.R.11W.W.M.

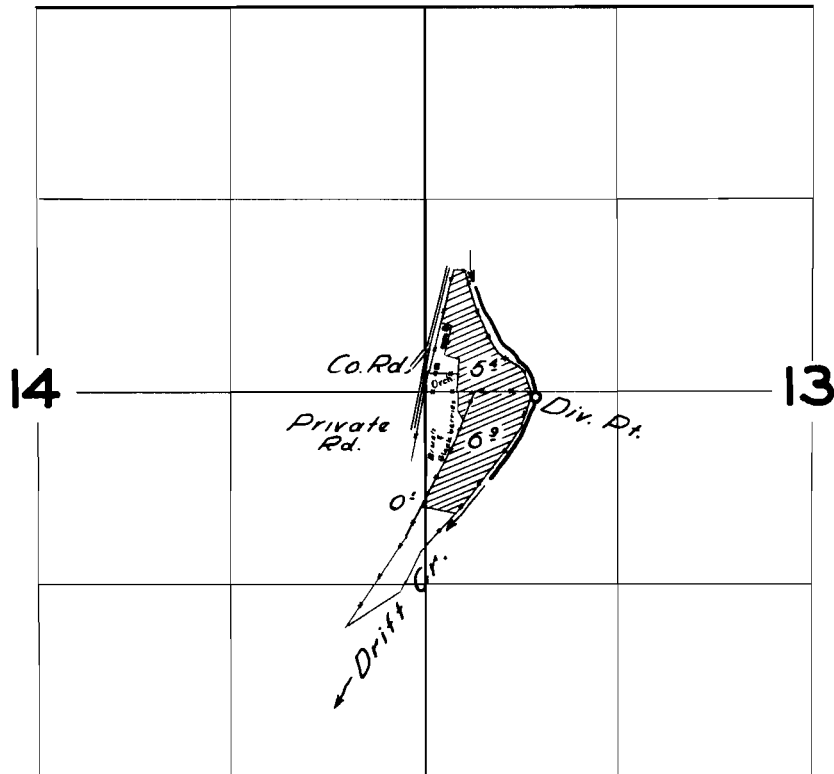

**FINAL PROOF SURVEY**  
UNDER

Application No. 27987 Permit No. 22030  
IN NAME OF

ALBERT O. LYNDON

Surveyed 5 Aug 1957, by Edw. Kelley