


T. 4S. R. IW. W.M.

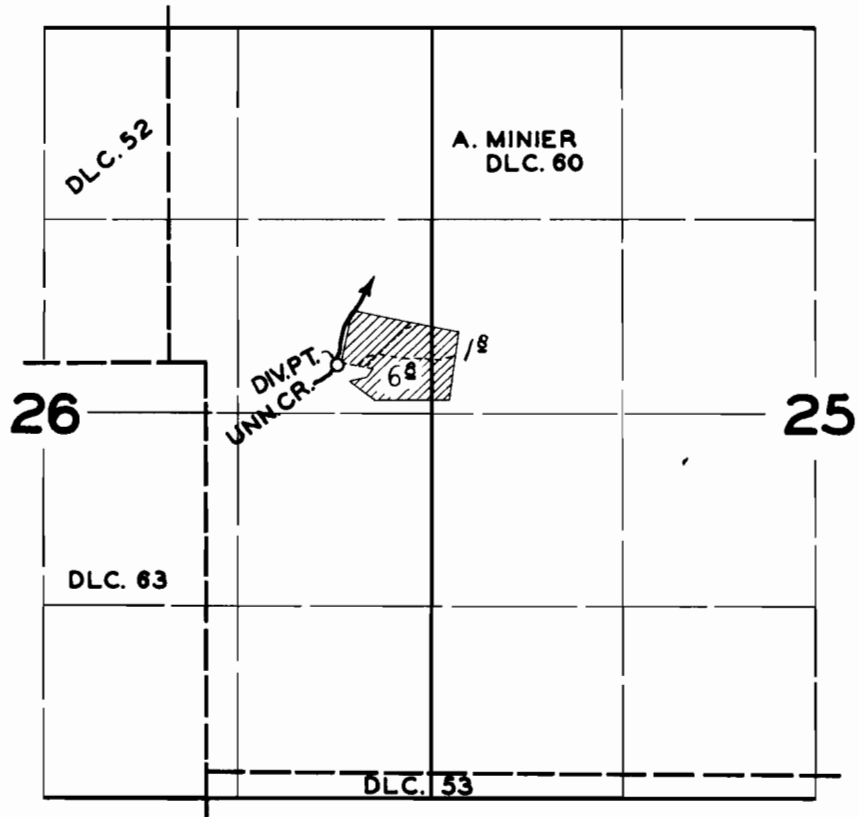

FINAL PROOF SURVEY

UNDER

Application No. 26130 Permit No. 22094

IN NAME OF

FRANK W. ANDERSON

Surveyed AUG. 21, 1957, by C.O. BARTELS