


T.6S.R.7W.W.M.

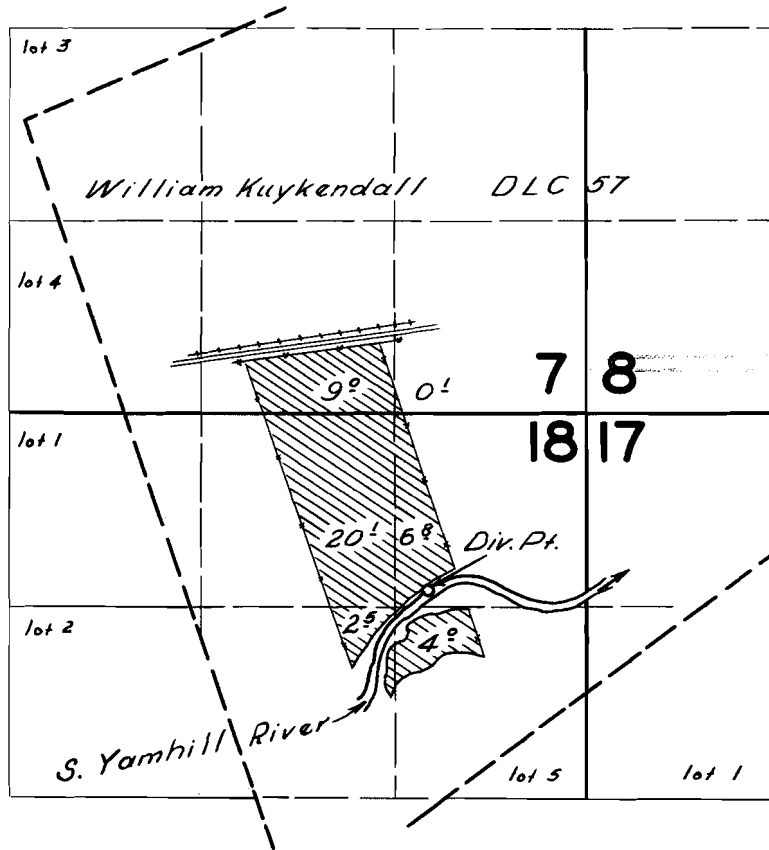

FINAL PROOF SURVEY
UNDER

Application No. 27823 Permit No. 22103
IN NAME OF

E. J. SCHUERCH

Surveyed 30 July 1957, by [Signature]