


T.15S.R.12W.W.M.

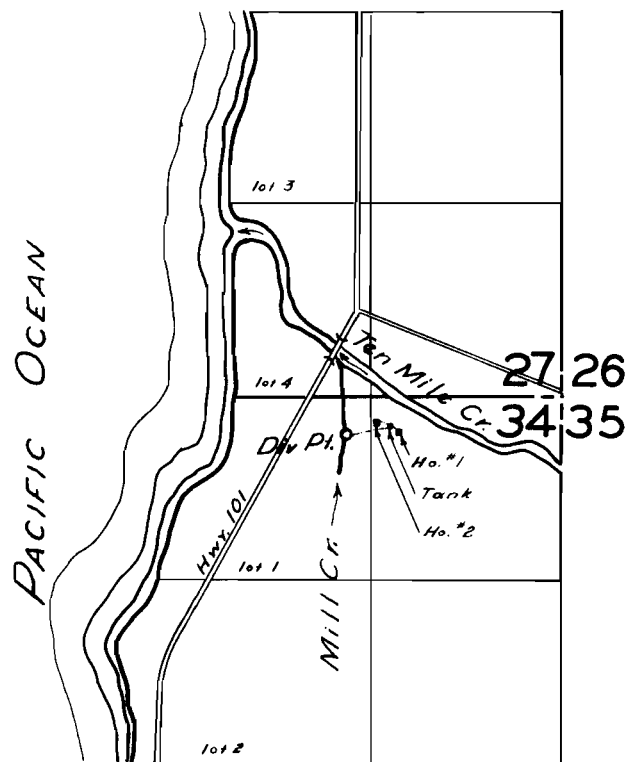

FINAL PROOF SURVEY
UNDER

Application No. 28016 Permit No. 22115
IN NAME OF

PAUL CARPENTER & D. PALMER YOUNG

Surveyed 26 May 1957, by [Signature]