


Per 22264  
2444

T. 13 S. R. 28 E. W. W.

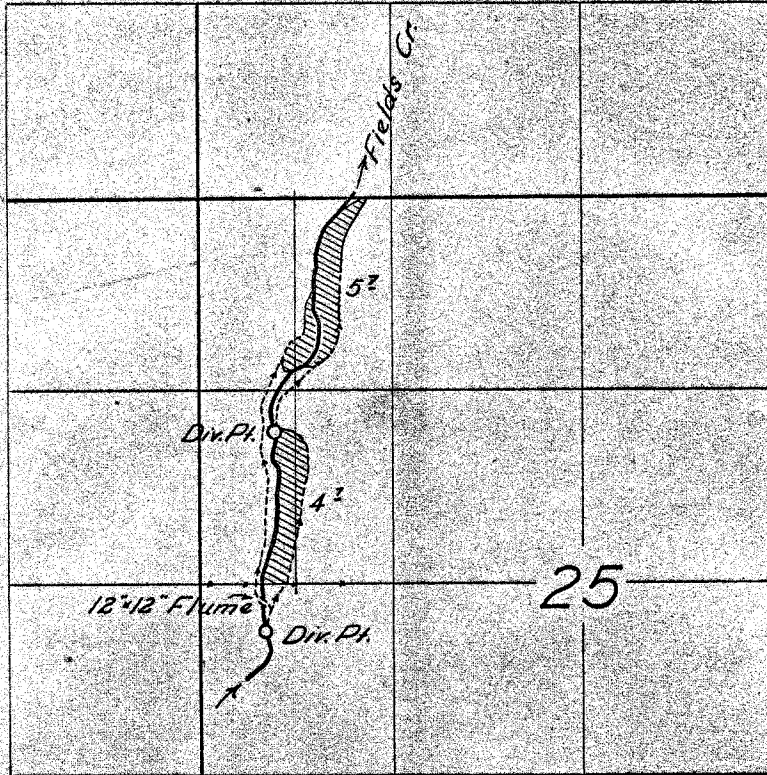

**FINAL PROOF SURVEY**  
UNDER

Application No. 28310 Permit No. 22264  
IN NAME OF

ROBERT DALE KINCAID

Surveyed 26 June 1957, by [Signature]