


T. 6S. R. IW. W.M.

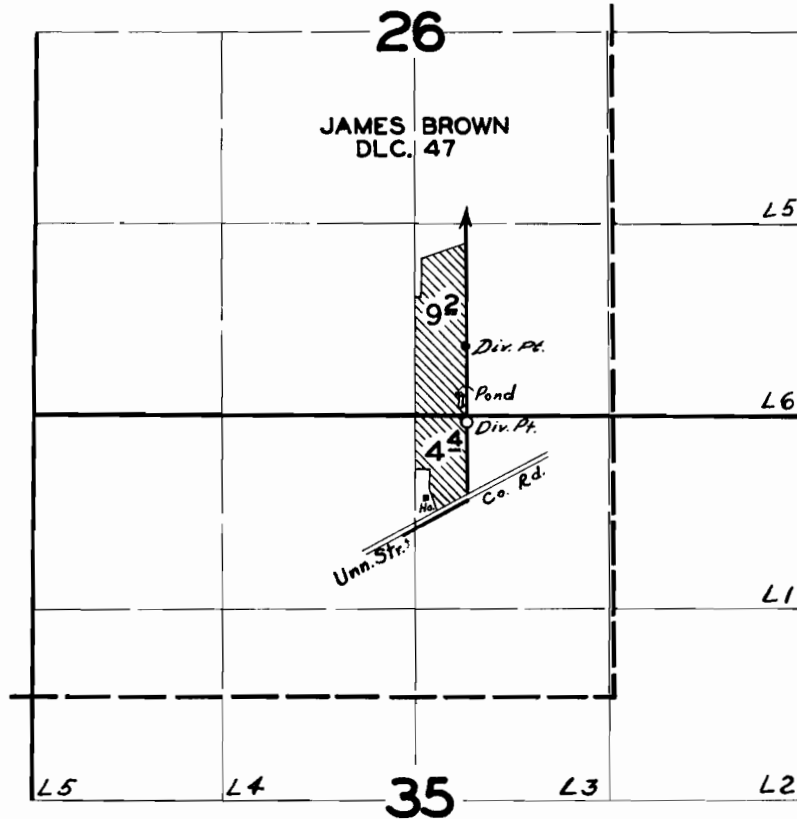

FINAL PROOF SURVEY

UNDER

Application No. 28359 Permit No. 22455
IN NAME OF

R.O. SOLUM

Surveyed MAR. 15 1957, by *A. B. Bate*