


T.7S.R.10W.W.M.

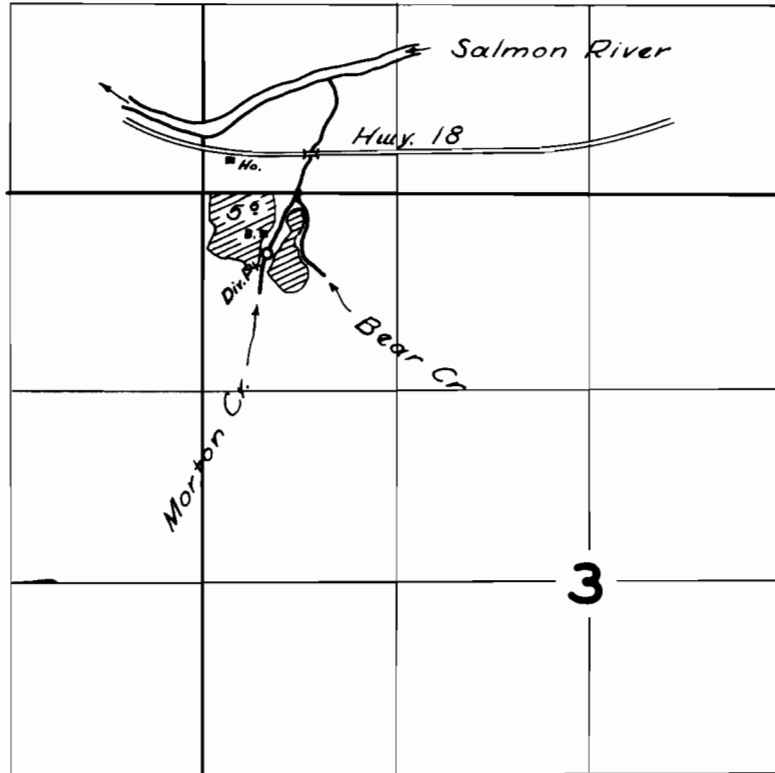

FINAL PROOF SURVEY

UNDER

Application No. 27469 Permit No. 22479

IN NAME OF

D. L. & Mrs. Tatro

Surveyed 6 Aug. 1957, by [Signature]