


Per 22979  
24449

# T. 8S. R. 29E. W.M.

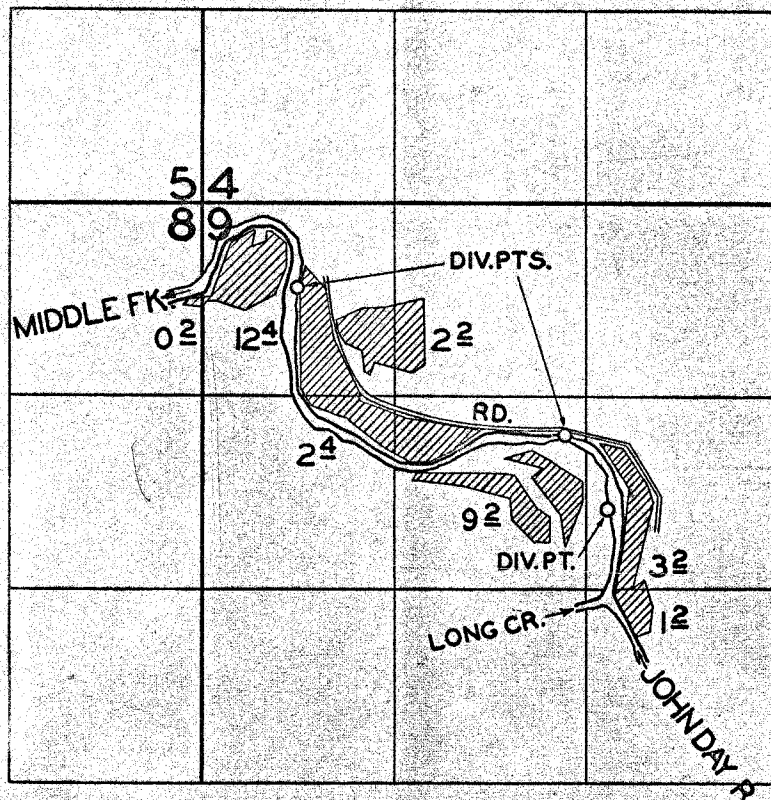

## FINAL PROOF SURVEY UNDER

Application No. 29130... Permit No. 22979  
IN NAME OF

A.C. HEISE

Surveyed JUL 12 13 1957, by *[Signature]*