


T. 3S. R. 9W. W.M.

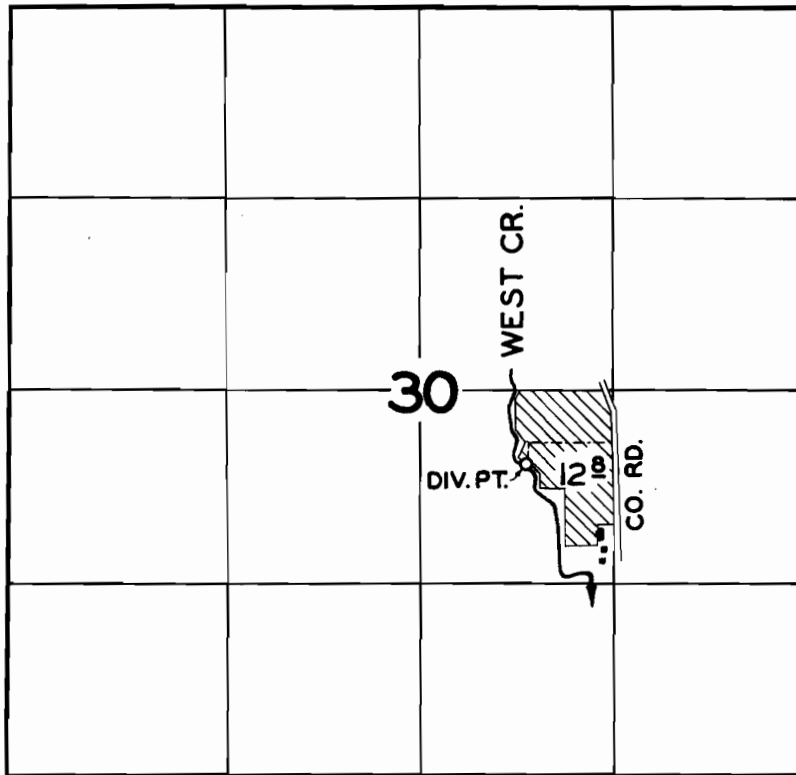

**FINAL PROOF SURVEY**  
UNDER

Application No. 29139 Permit No. 22981  
IN NAME OF

LOYD C. MASON

Surveyed AUG. 9, 1957, by *[Signature]*