


T.2S.R.3E.W.W.

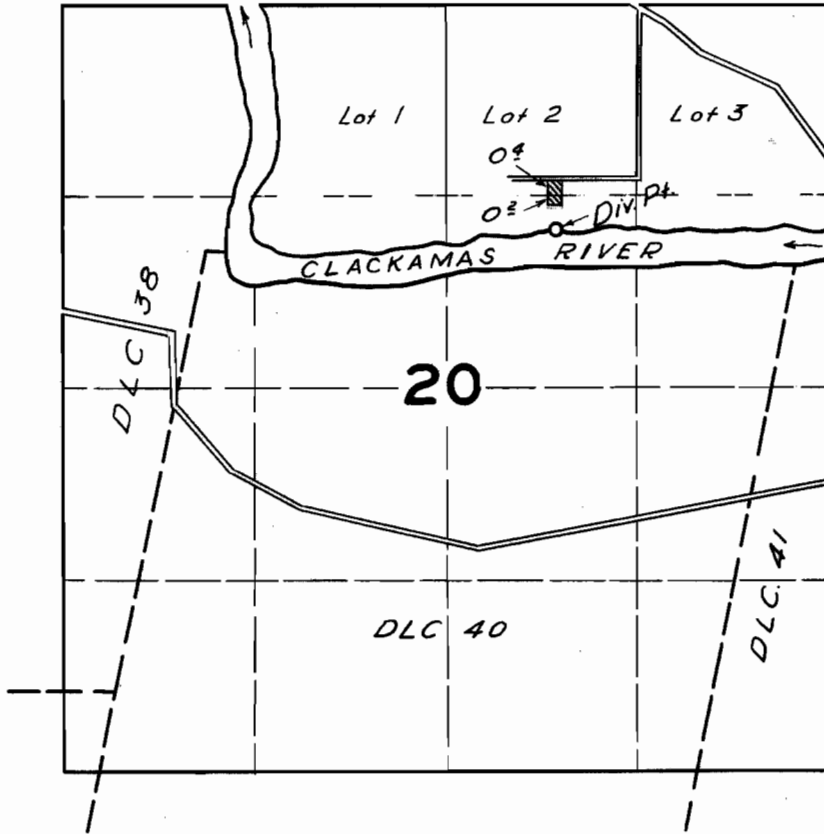

FINAL PROOF SURVEY UNDER

Application No. 29185 Permit No. 22994
IN NAME OF

Louise W. SCHROEDER

Surveyed 29 June 1956, by [Signature]