


T.16S.R.2 E.W.M.

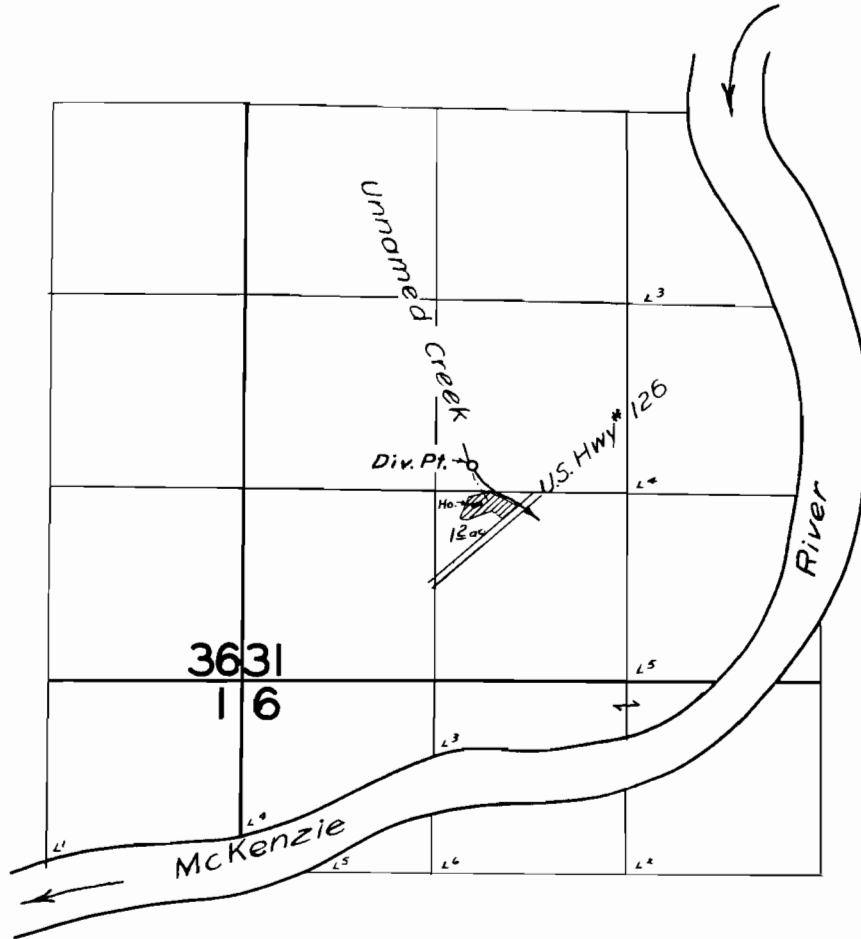

FINAL PROOF SURVEY

UNDER

Application No. 28096 Permit No. 23051

IN NAME OF

David C. & Gale H. Burwell

Surveyed July 2 1957, by M. Bush