


T.18S.R.5W.W.M.

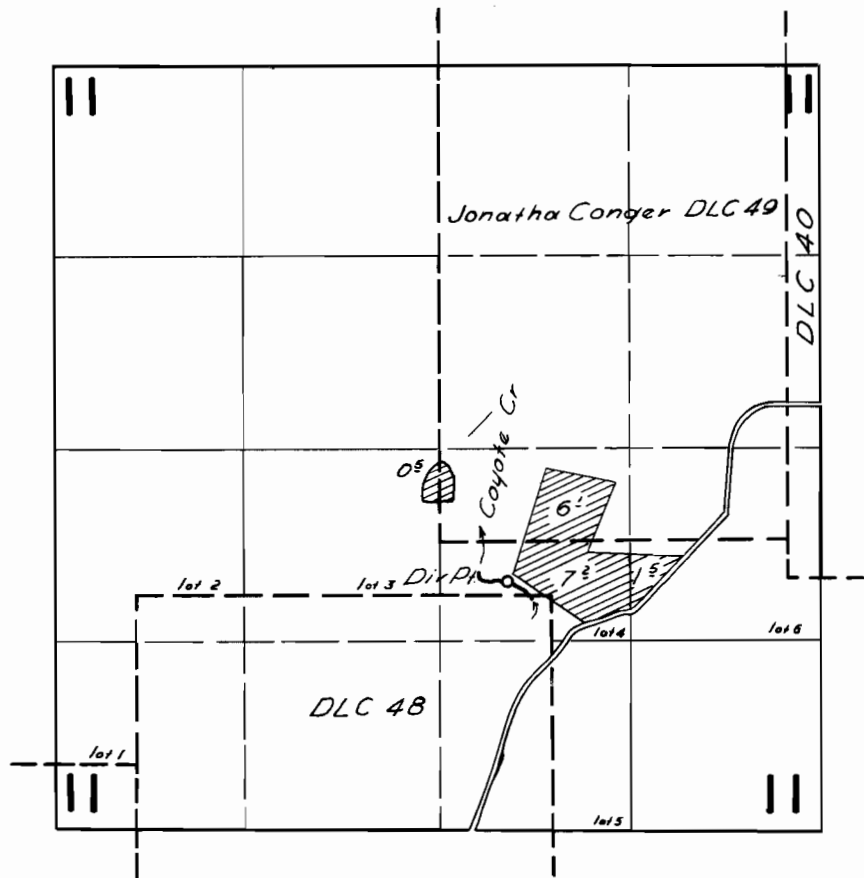

FINAL PROOF SURVEY
UNDER

Application No. 28409 Permit No. 23105
IN NAME OF _____

DOUGLAS F. HIBLER

Surveyed 6 May 1957, by Chas. H. L. By