


T.18 S.R.1 W.W.M.

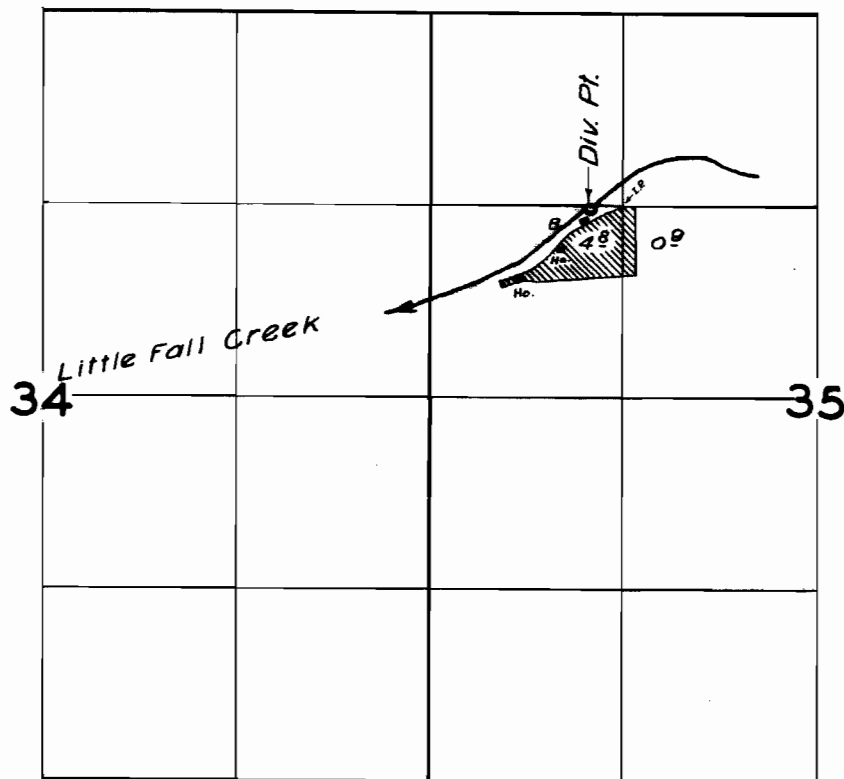

FINAL PROOF SURVEY

UNDER

Application No. 29615 Permit No. 23312

IN NAME OF

Harry & Edna Adkins

Surveyed June 19 1957, by M. A. Bisher