


T.16S.R.7W.W.M.

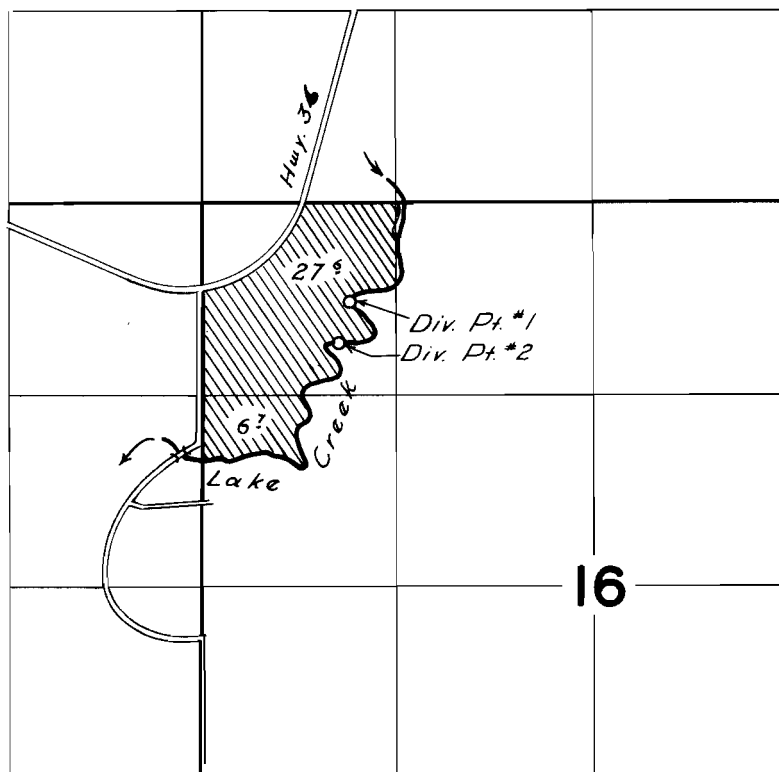

FINAL PROOF SURVEY
UNDER

Application No. 22790 Permit No. 23323
IN NAME OF

GLENN E. MILLER

Surveyed 16 May 1957, by *CC. Ketchum*