


T.16 S.R.4 E.W.M. :

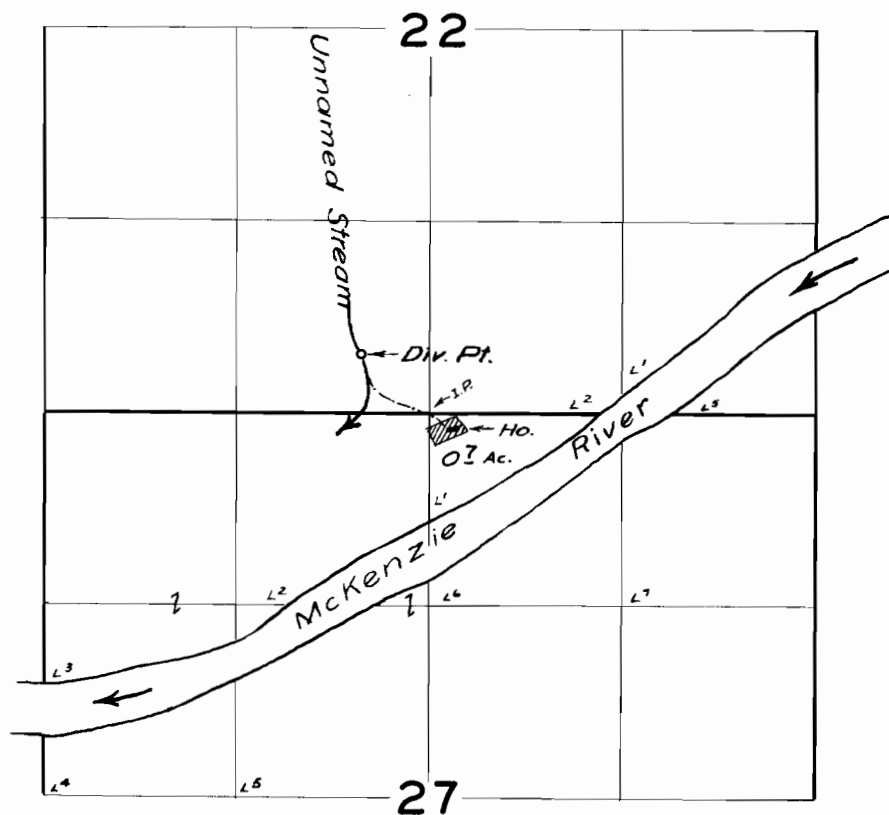

FINAL PROOF SURVEY  
UNDER

Application No. 30143 Permit No. 23785  
IN NAME OF

*Stewart R. Elder*

Surveyed June 29 1957, by *M. Bish*