


T. 6 S. R. 4 W. W. M.

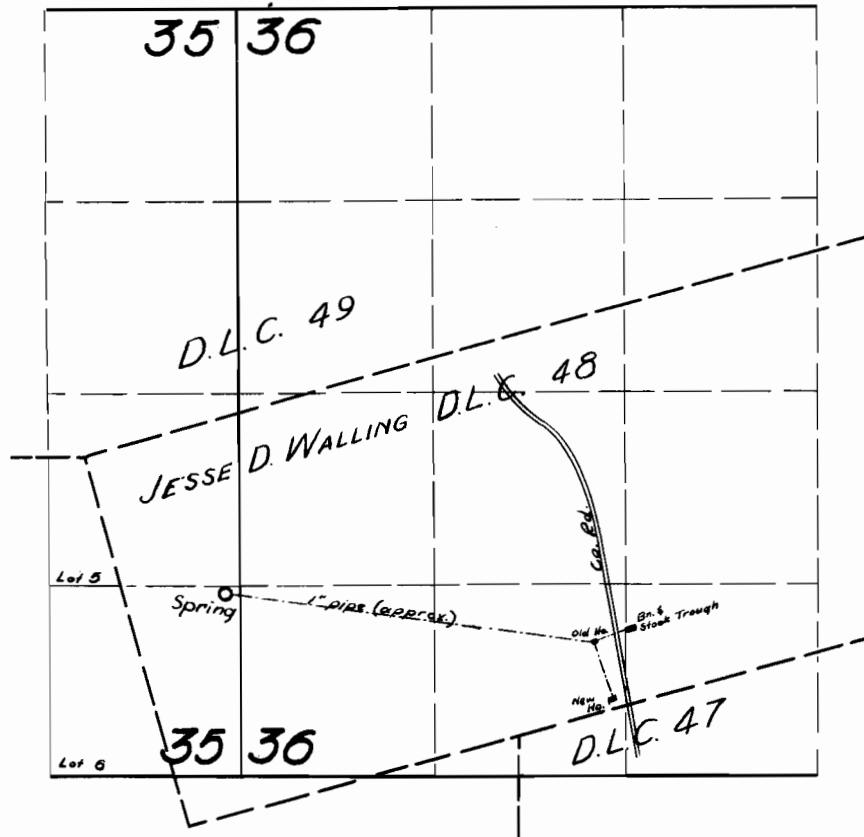

FINAL PROOF SURVEY

UNDER

Application No. 30987 Permit No. 24383

IN NAME OF

GRACE SHEPHARD

Surveyed 22 Mar. 1957, by E. H. Whiteley