


T16SR4EWM

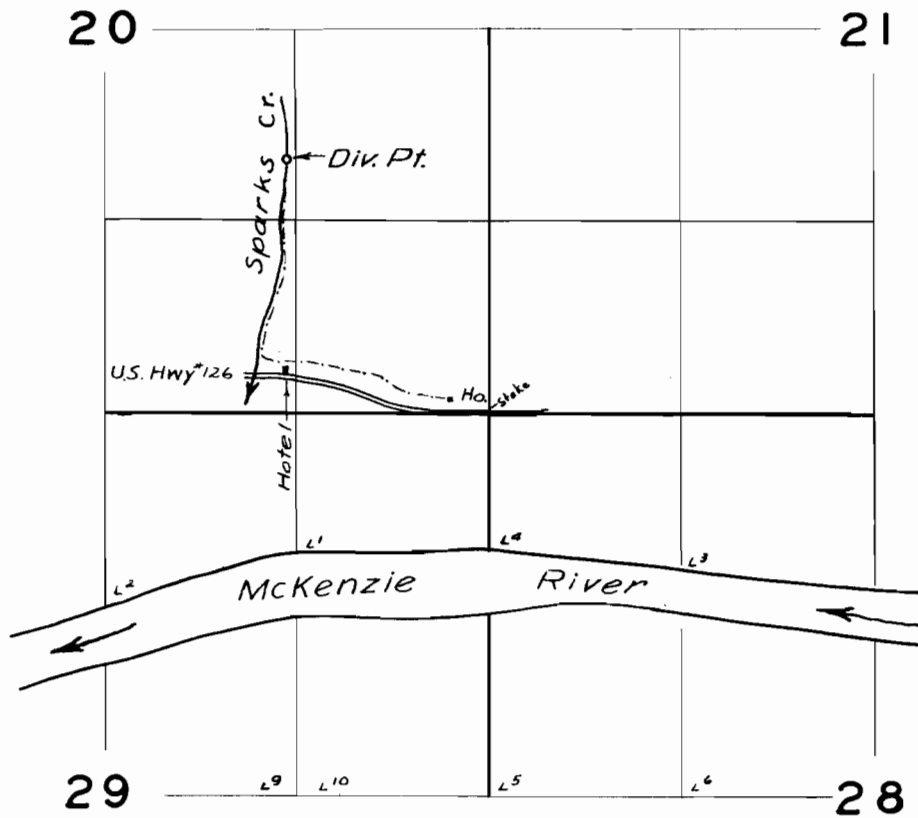

FINAL PROOF SURVEY

UNDER

Application No. 31209 Permit No. 24578

IN NAME OF

Walker E. & Manena Schwering

Surveyed July 1 1957, by M. Bish