


T.5S.R.5W.W.M.

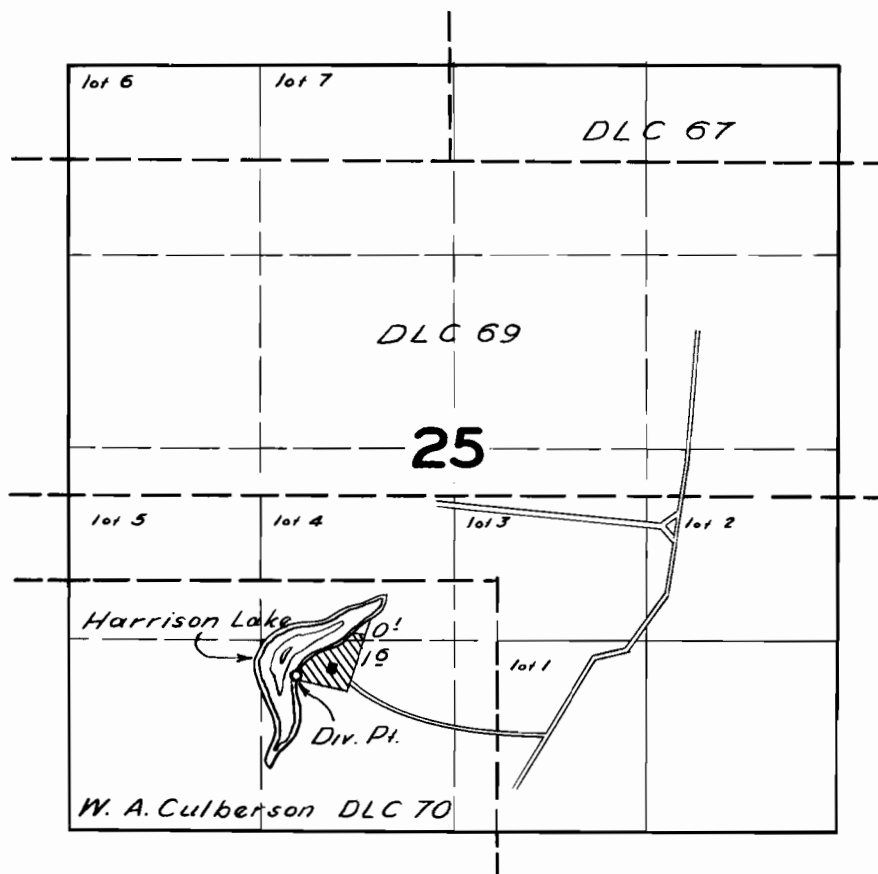

**FINAL PROOF SURVEY**  
UNDER

Application No. 31333 Permit No. 24693  
IN NAME OF

P. E. MEEKER

Surveyed 7 June 1957, by [Signature]