


# T.4 S.R.4 W.W.M.

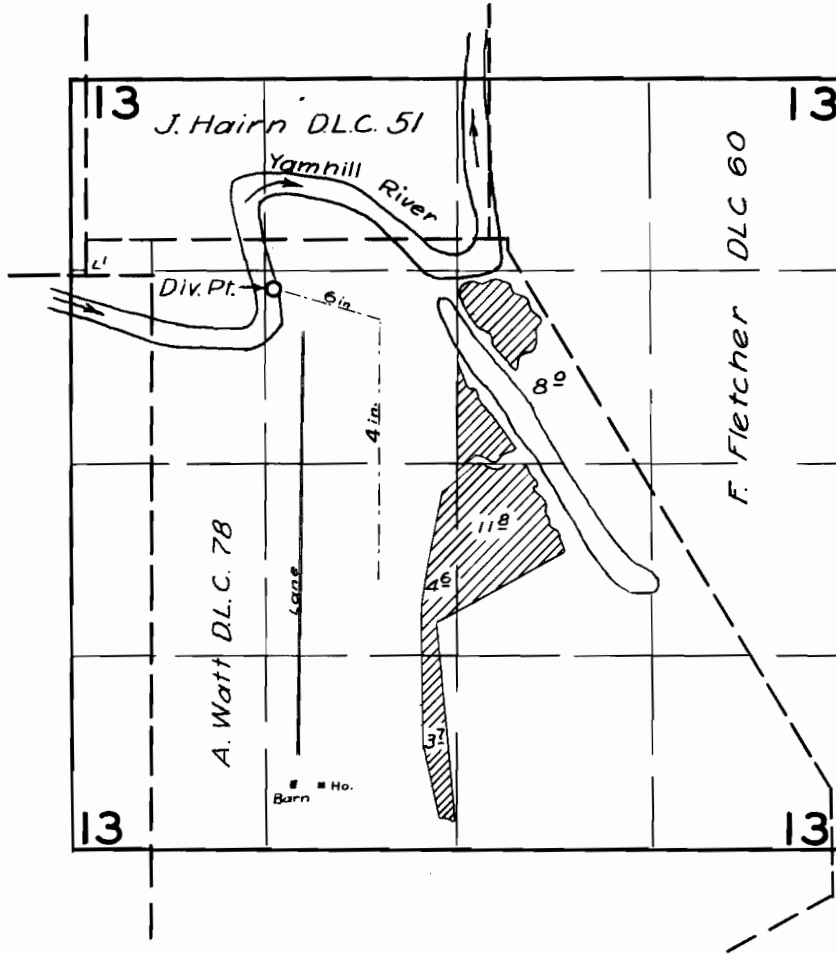

## FINAL PROOF SURVEY UNDER

Application No. *31395* Permit No. *24749*  
IN NAME OF

*Marvin D. Williams*

Surveyed *Mar. 15* 1956, by *Mr. Bish*