


# T. I. S. R. 9 W. W. M.

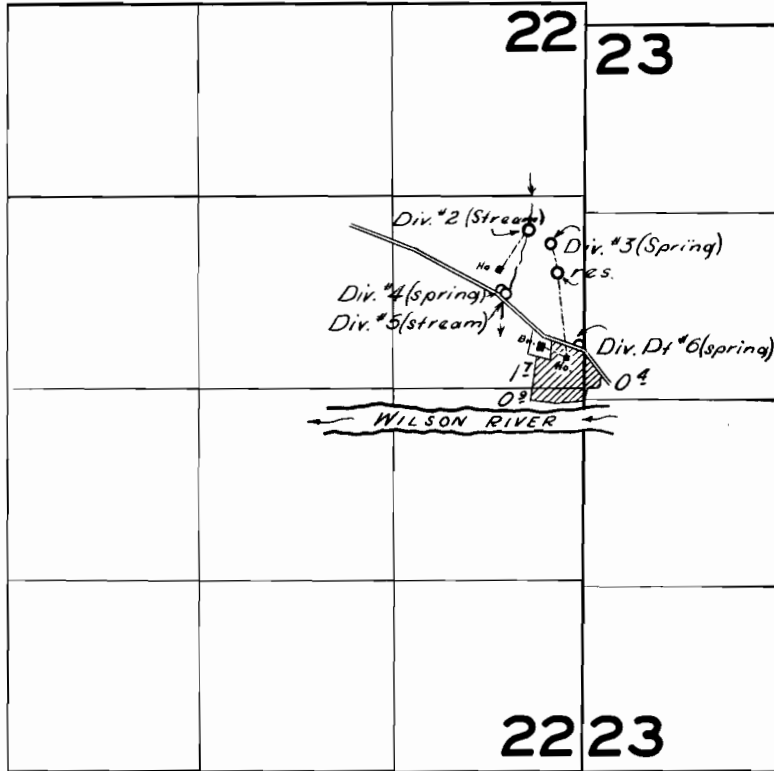

## FINAL PROOF SURVEY UNDER

Application No. 20351... Permit No. 15874  
IN NAME OF

*LEO B. SANDER*

Surveyed 10 Aug 1957, by *[Signature]*