


T. 4S. R. 12&13E. W.M.

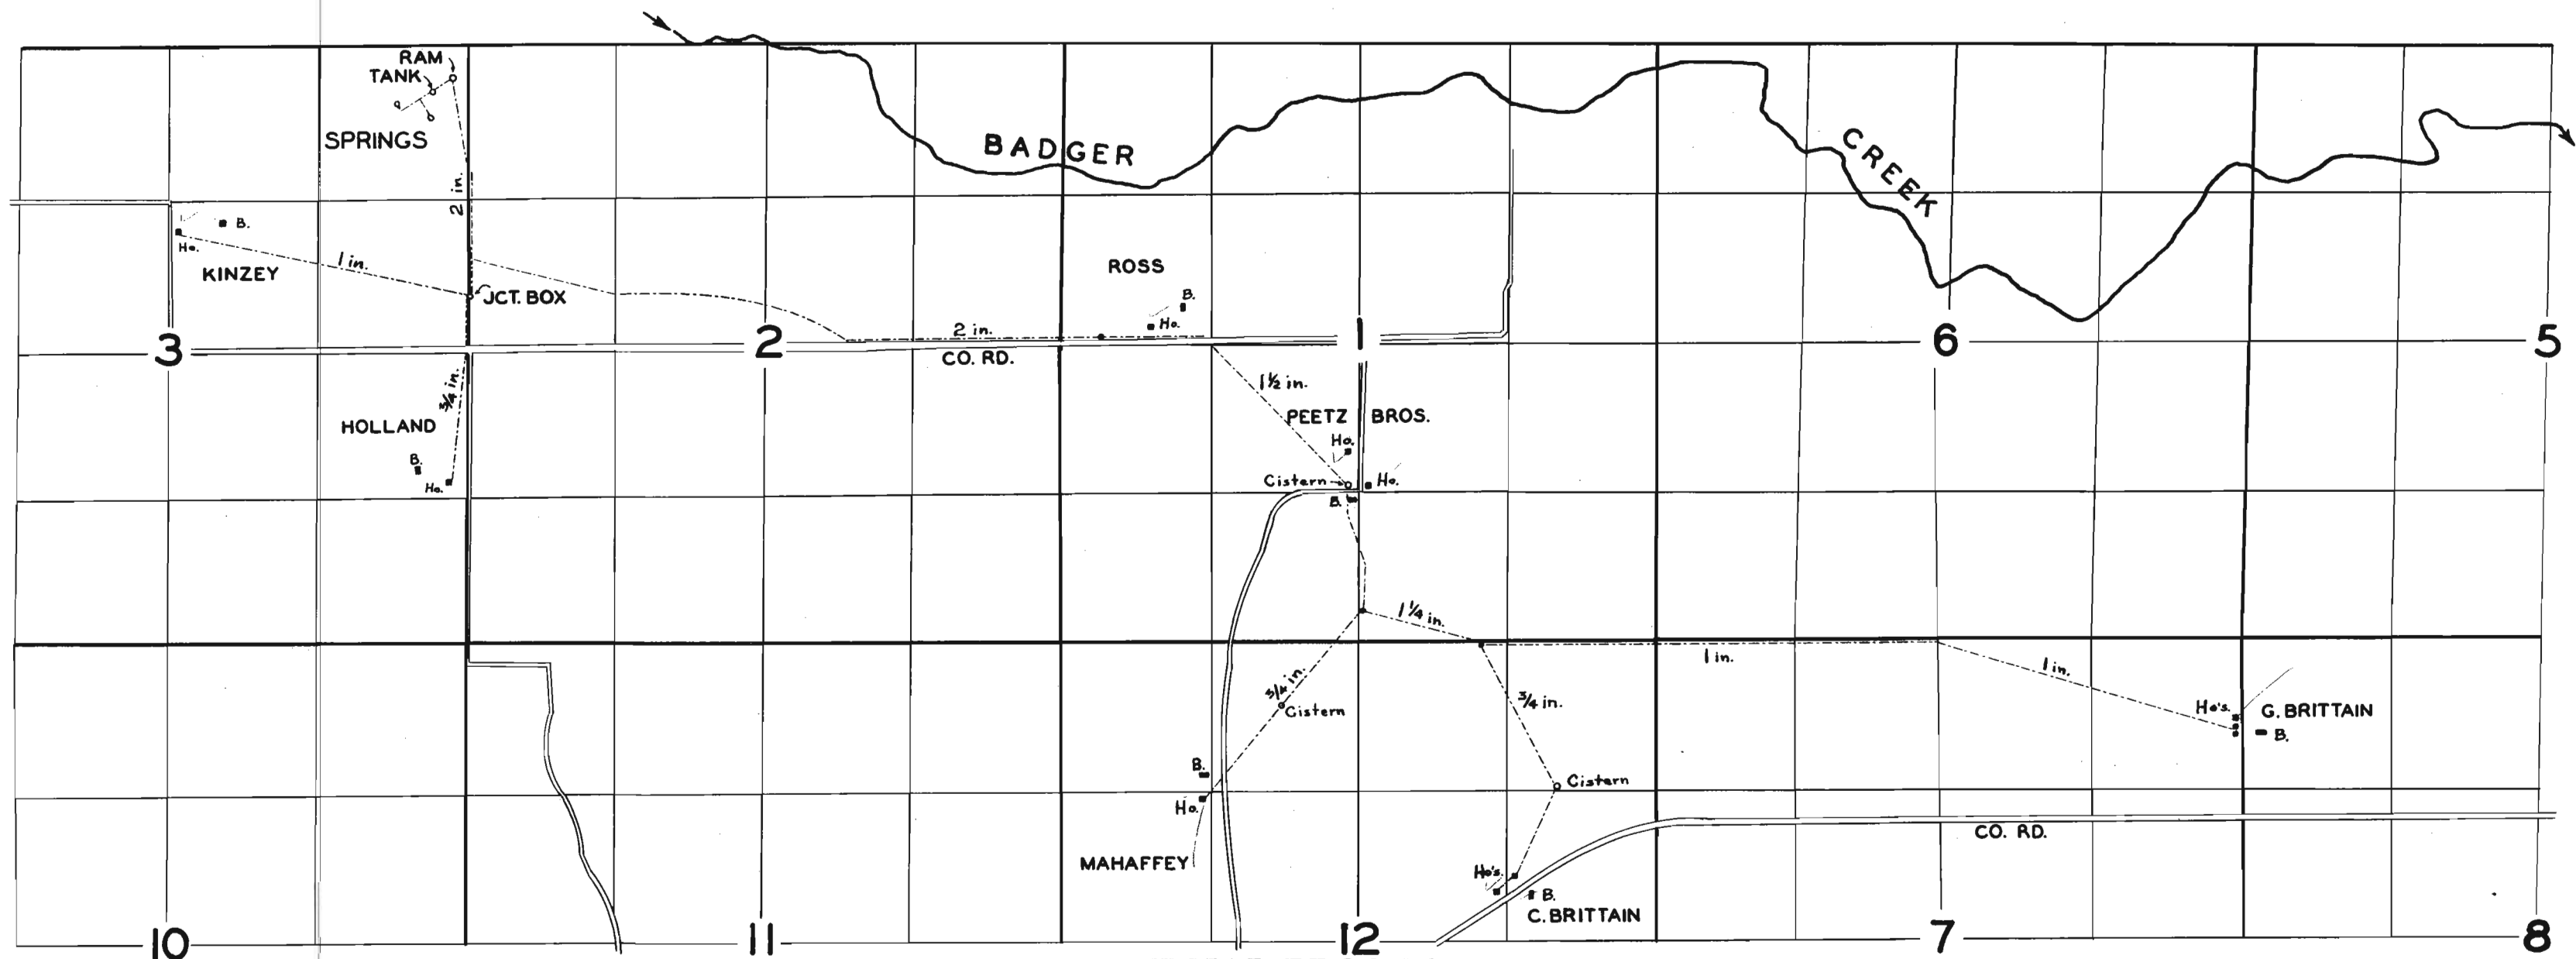

FINAL PROOF SURVEY

UNDER

Application No. 21644. Permit No. 17901

IN NAME OF

SHEAR SPRING WATER ASSOCIATION, INC.

Surveyed OCT. 22 19 57, by *m. Bish*

Application No. 33049

Permit No. 26140