


T. 4 S. R. 4 W. W. M.

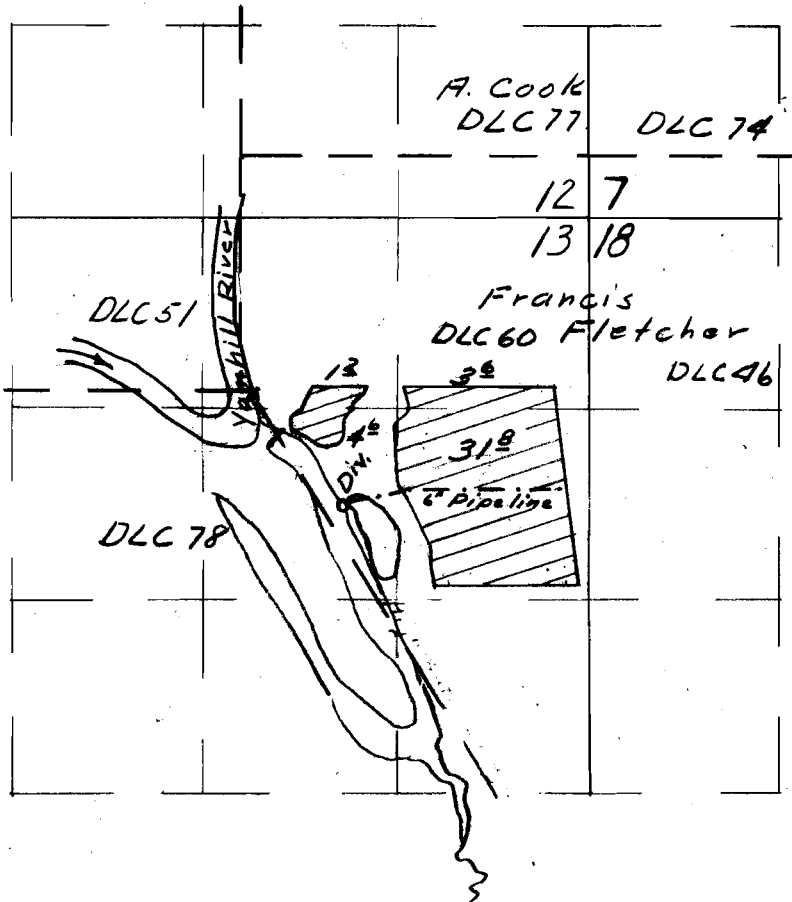

Final Proof Survey
UNDER

Application No. ^{R-24250} 34251 ^{R-1122} Permit No. 20185
In Name Of

G. M. Rhein

Surveyed May 27, 1955 by T. Jones