


# T. 7S. R. 4W. W.M.

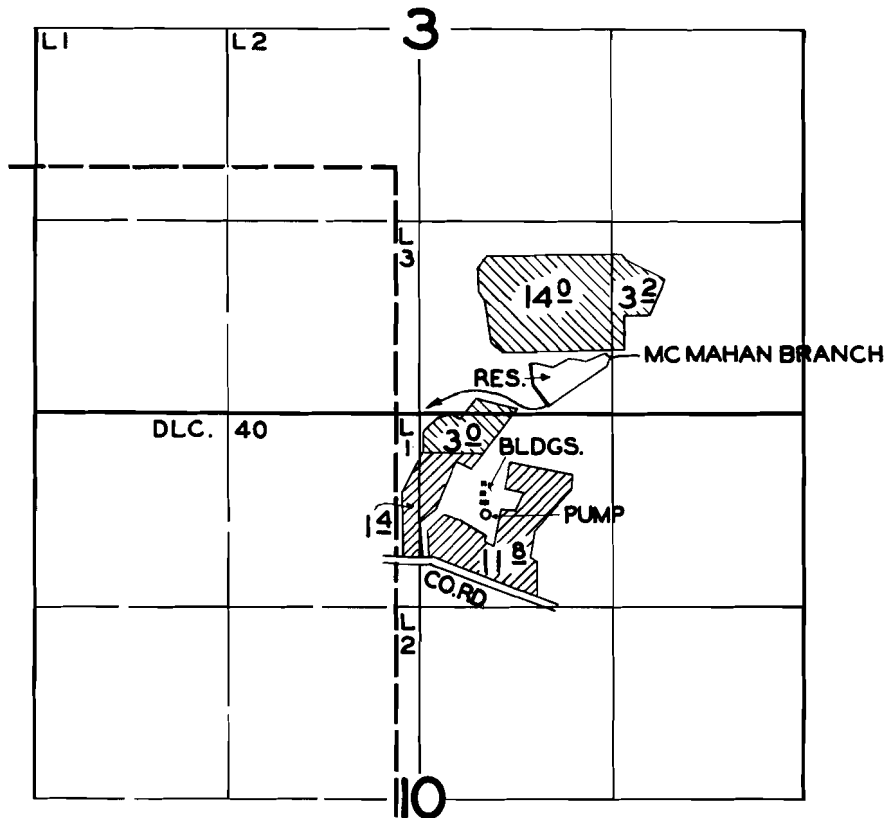

## FINAL PROOF SURVEY UNDER

R-29950  
29951  
R-26070

R-1713  
23414  
R-1172



Application No. 26071 Permit No. 20393  
IN NAME OF

**ALLENE & MARY LUELLEA STEVENS**

Surveyed JULY 24, 1957, by *Ed. H. H. H.*