


T. 7S. R. 4W. W.M.

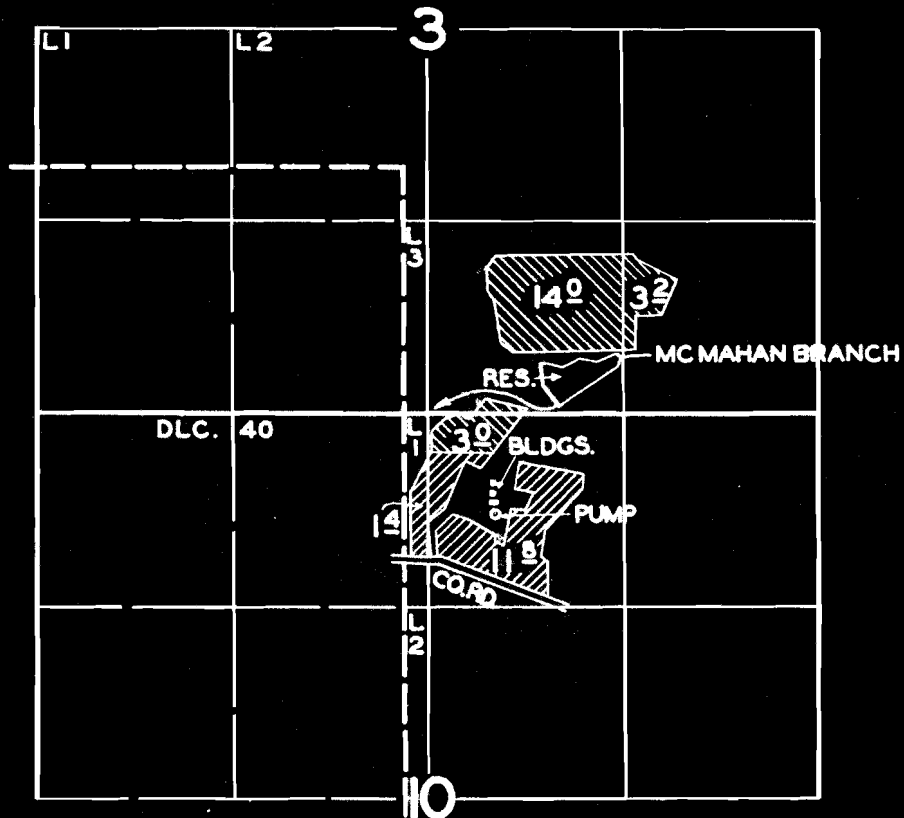

FINAL PROOF SURVEY UNDER

R-29950
29951
R-26070

R-1713
23414
R-1172



Application No. 26071 Permit No. 20393
IN NAME OF

ALLENE & MARY LUELLE STEVENS

Surveyed JULY 24, 1957, by *[Signature]*