


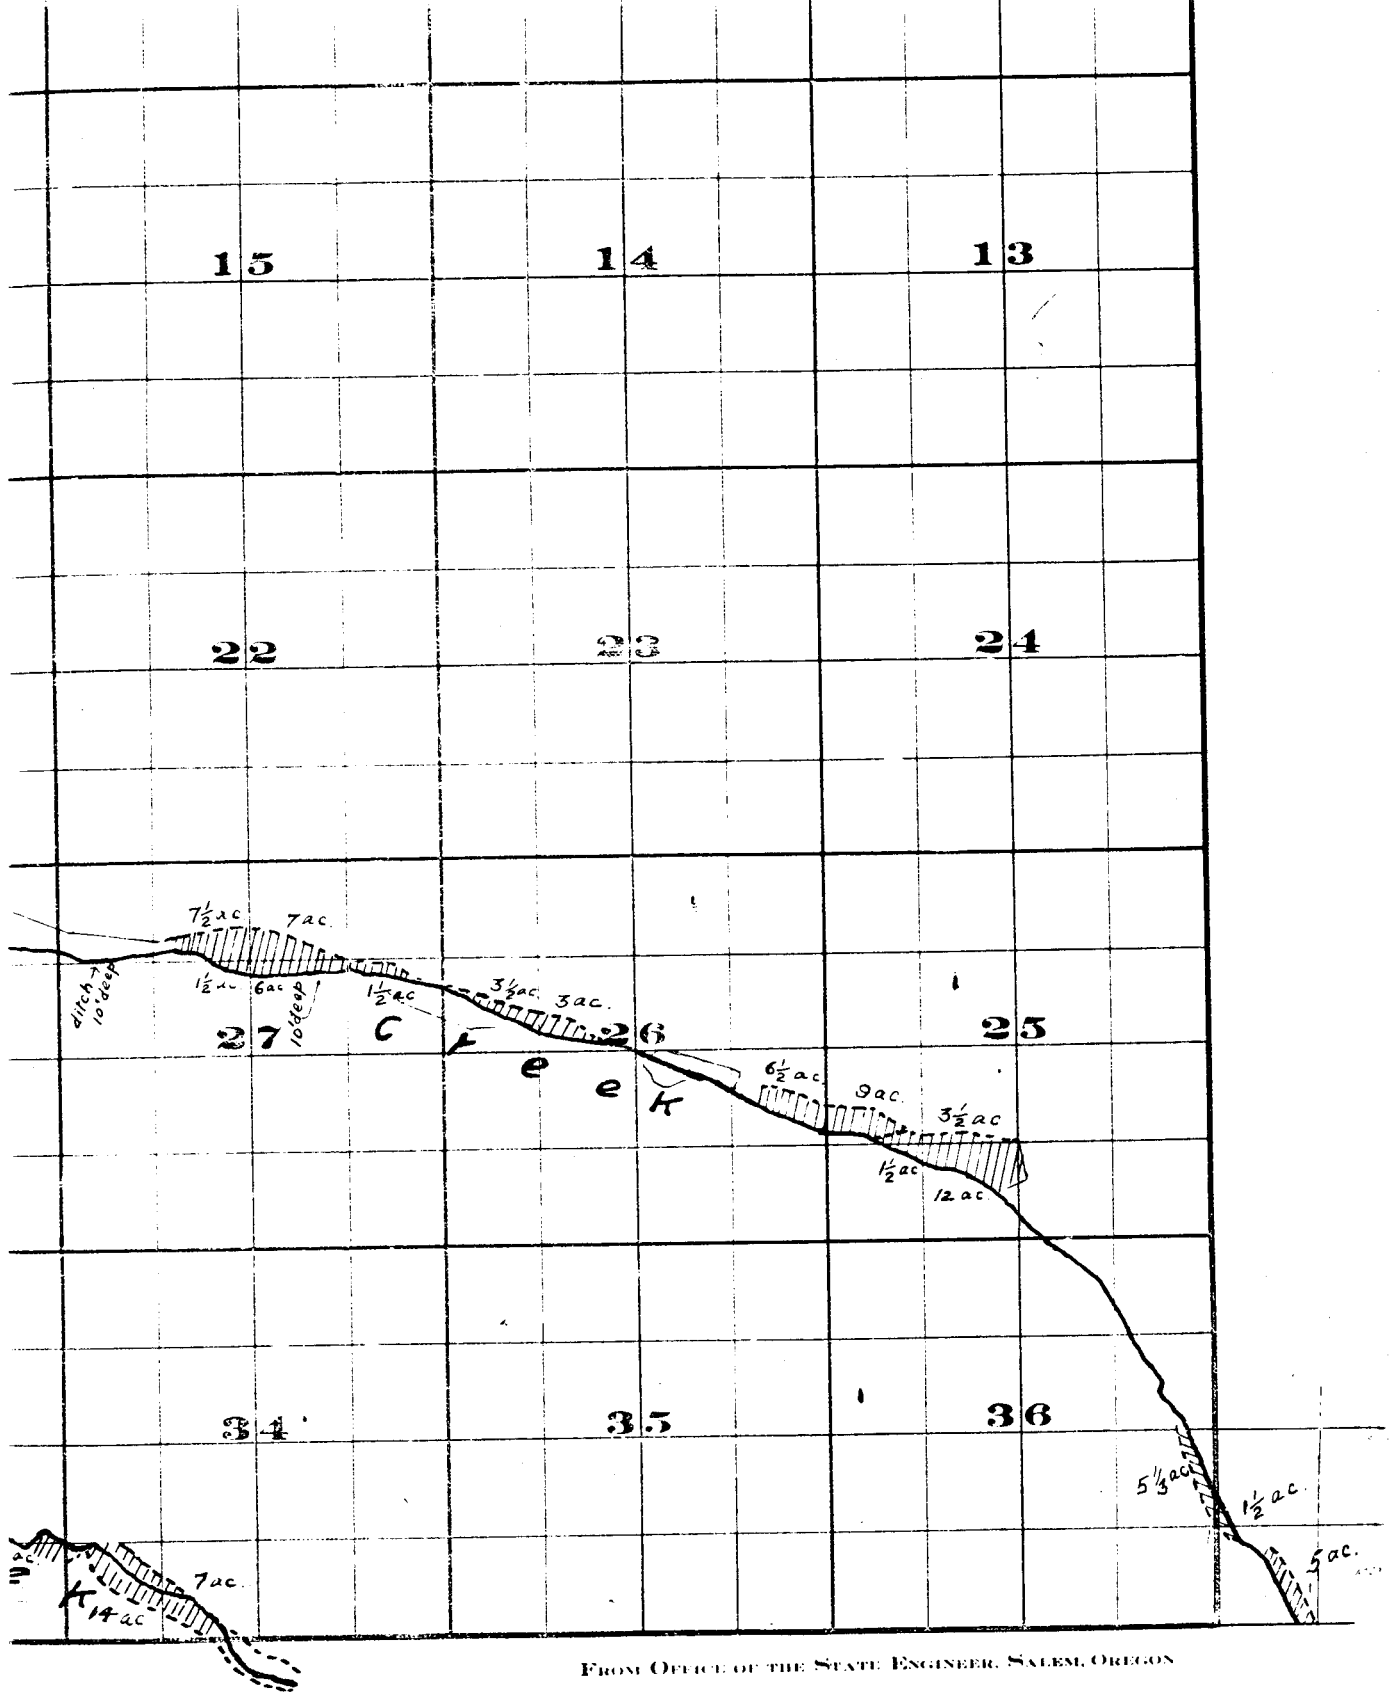

FROM OFFICE OF THE STATE ENGINEER, SALEM, OREGON

per July 1909
State Engineer

Willow Creek Adjudication

2 S. 27 E.


Part 2 S. 28 E.


Part 3 S. 27 E.

,

[illegible]

,

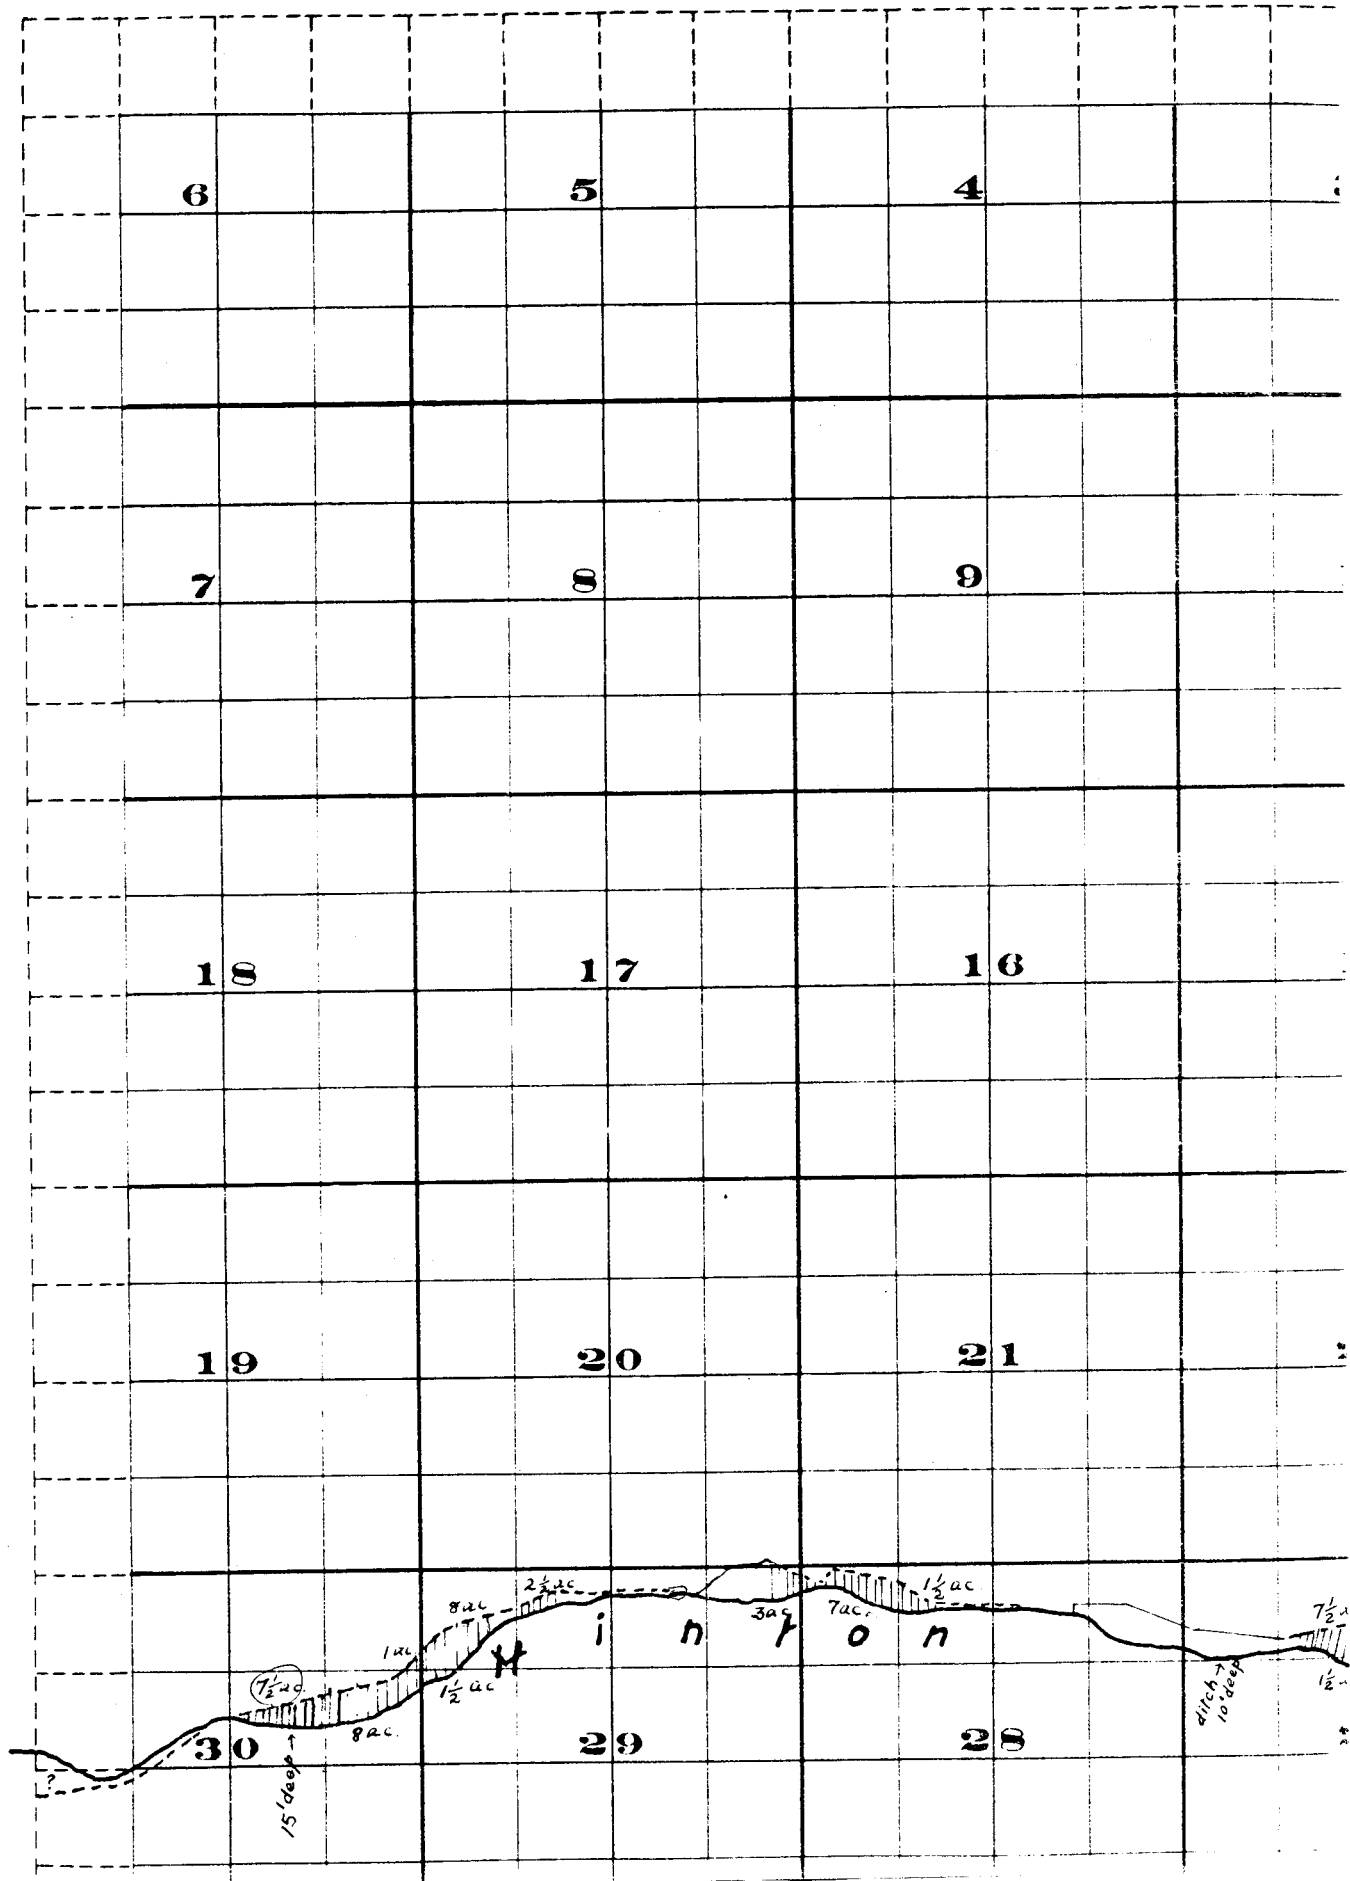

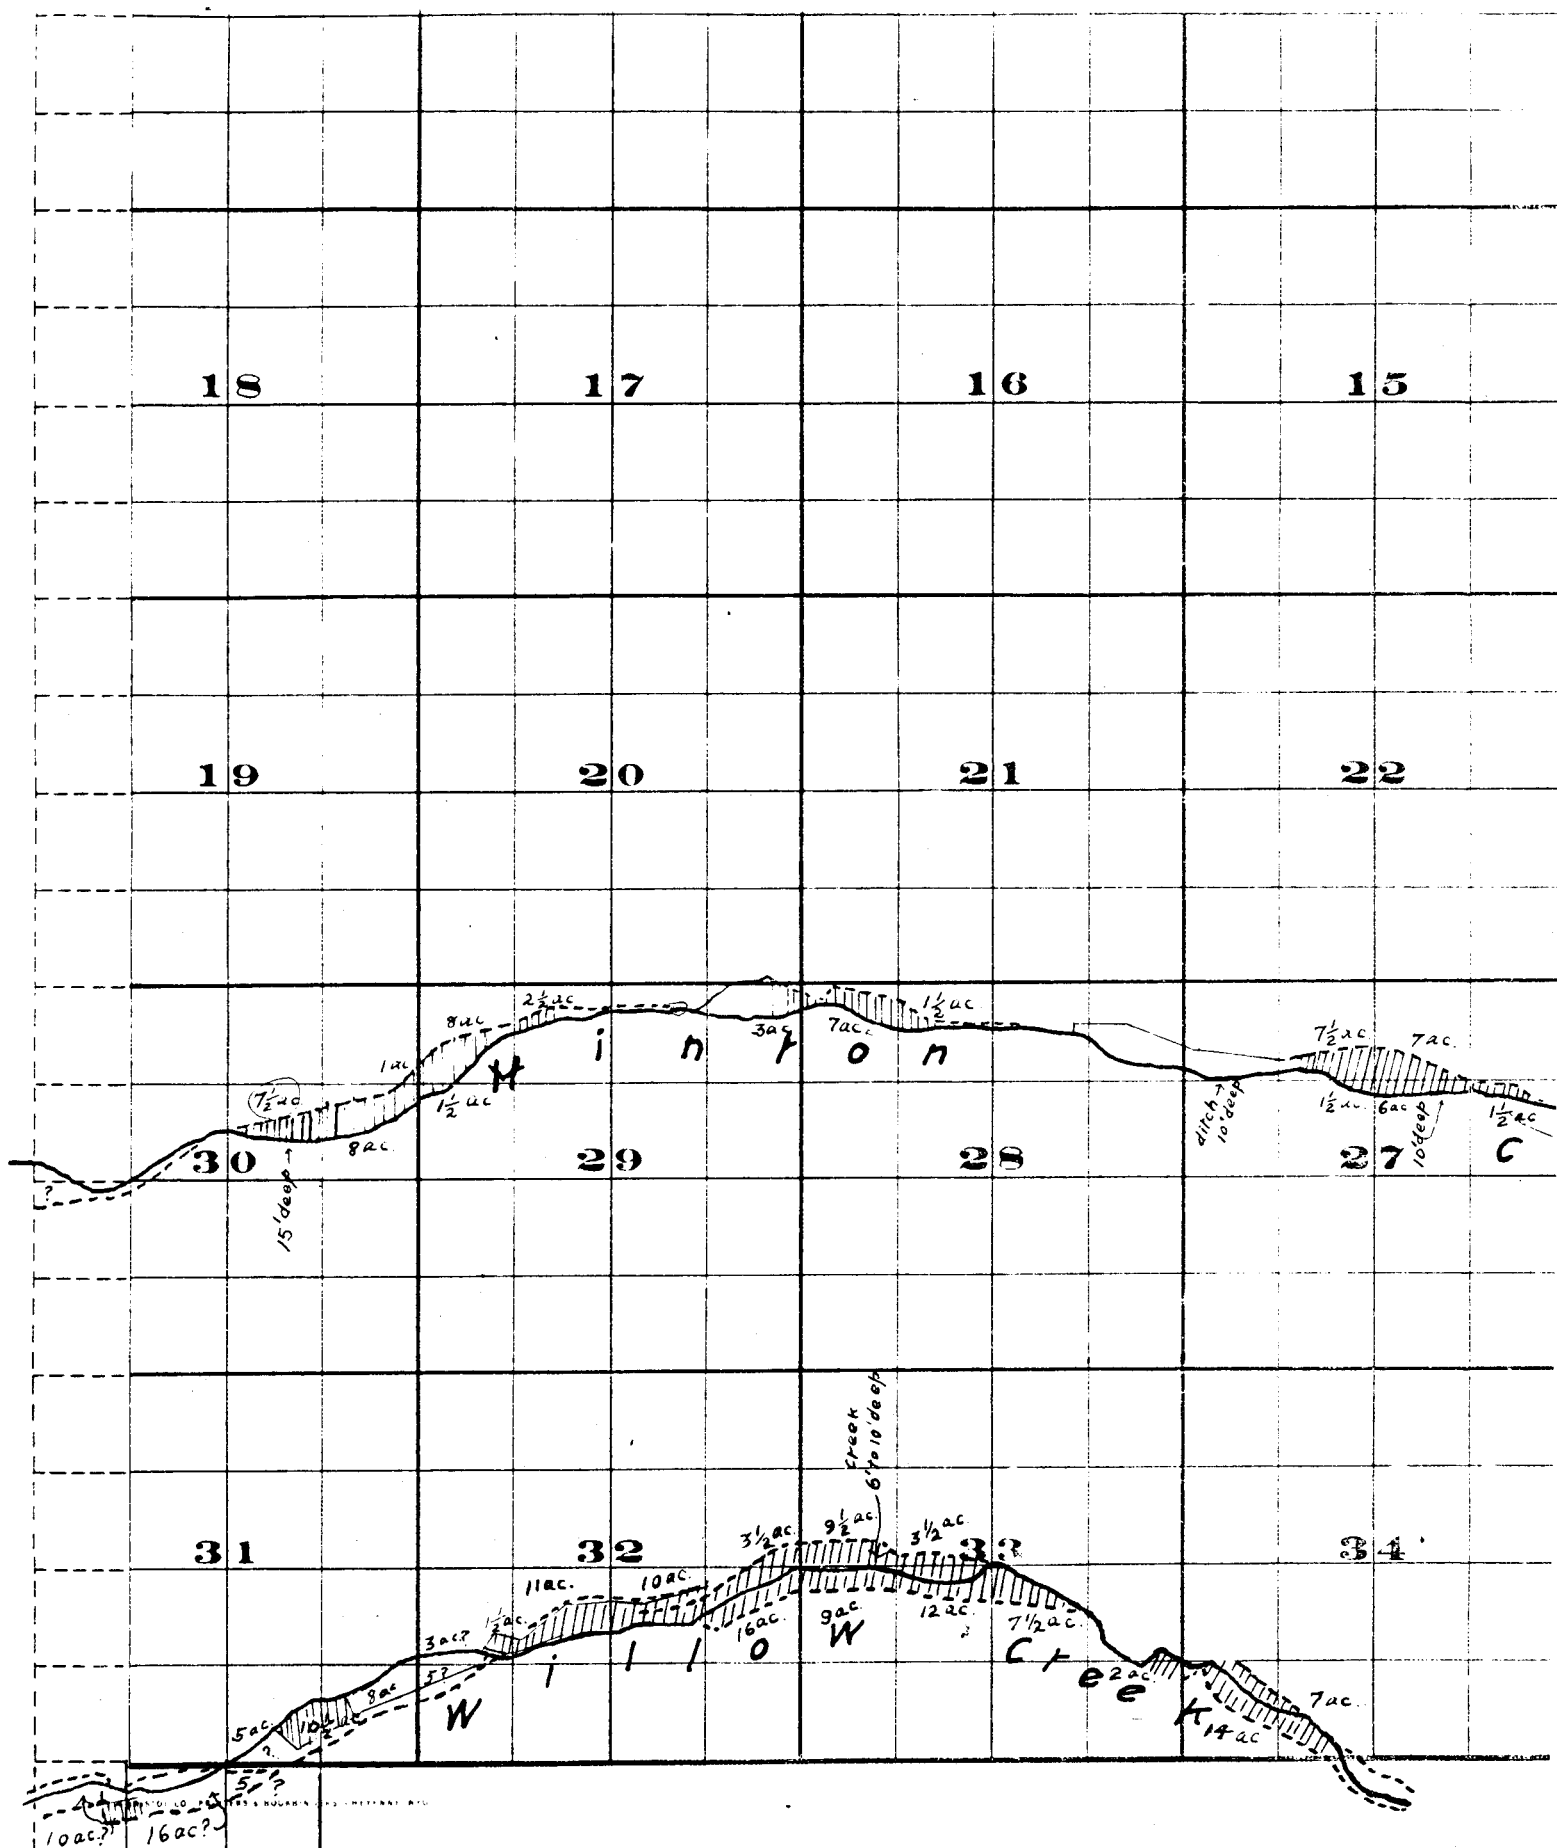

Surveyed by H. K. Donnelly & D. D. Cooper July
 John H. Lewis - State Engineer
 Examined July 14, 1909.