


T.13 & 14 S. R. 28 E. W. W.

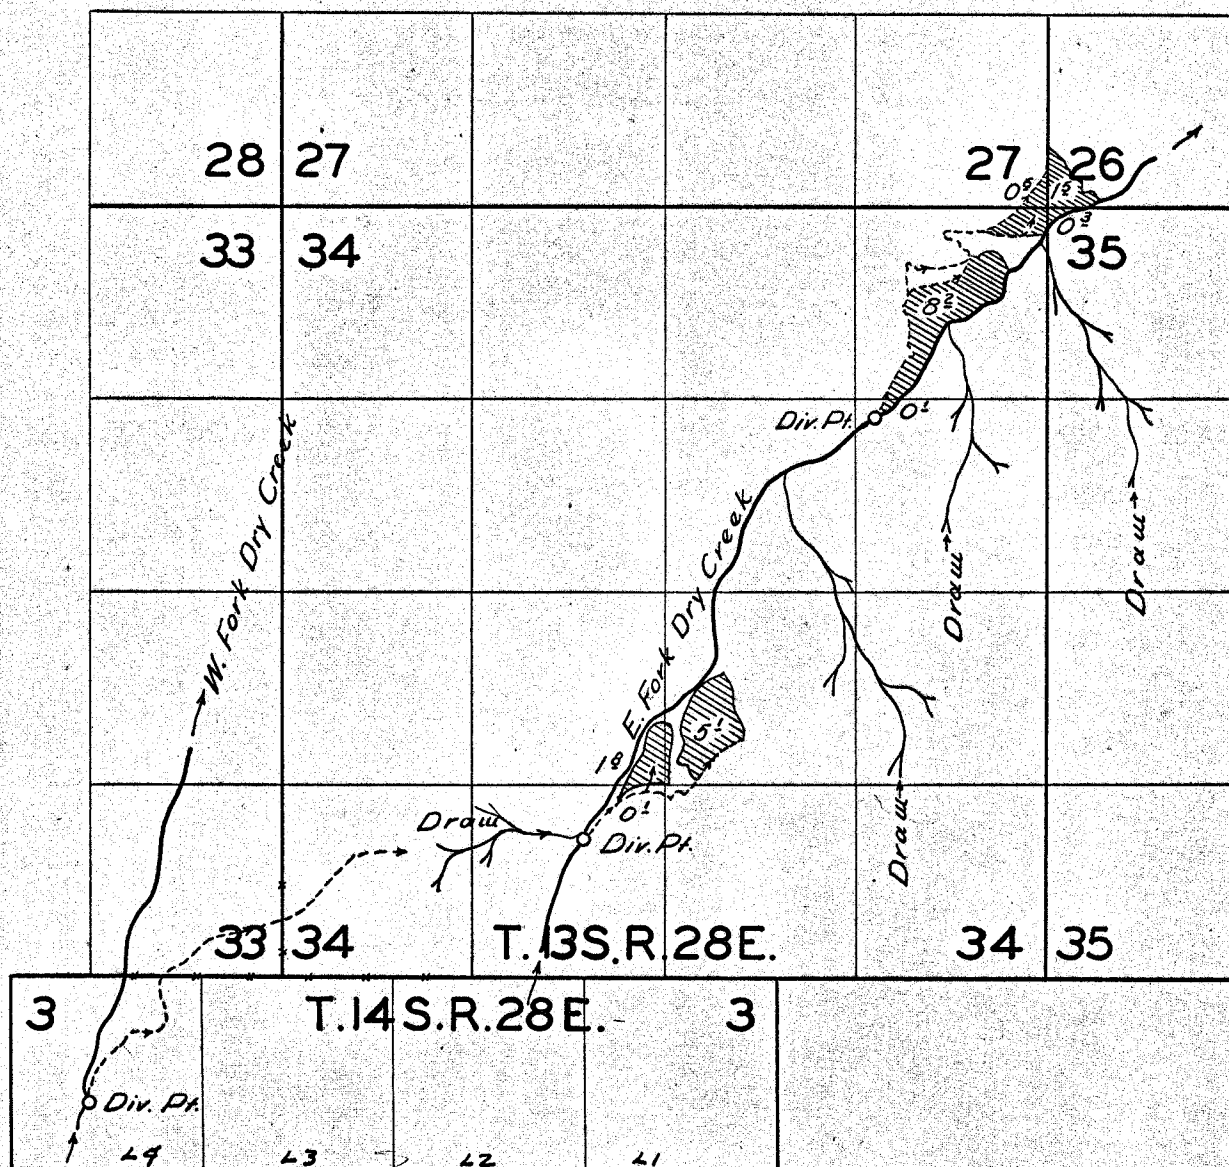

FINAL PROOF SURVEY UNDER

Application No. 15808 Permit No. 11654
IN NAME OF

GEROLD G. & MARTHA R. VANDER VLUGT

Surveyed 27 June 1957, by [Signature]