


9928
24510

T.34 S. R.7E.W.M.

33

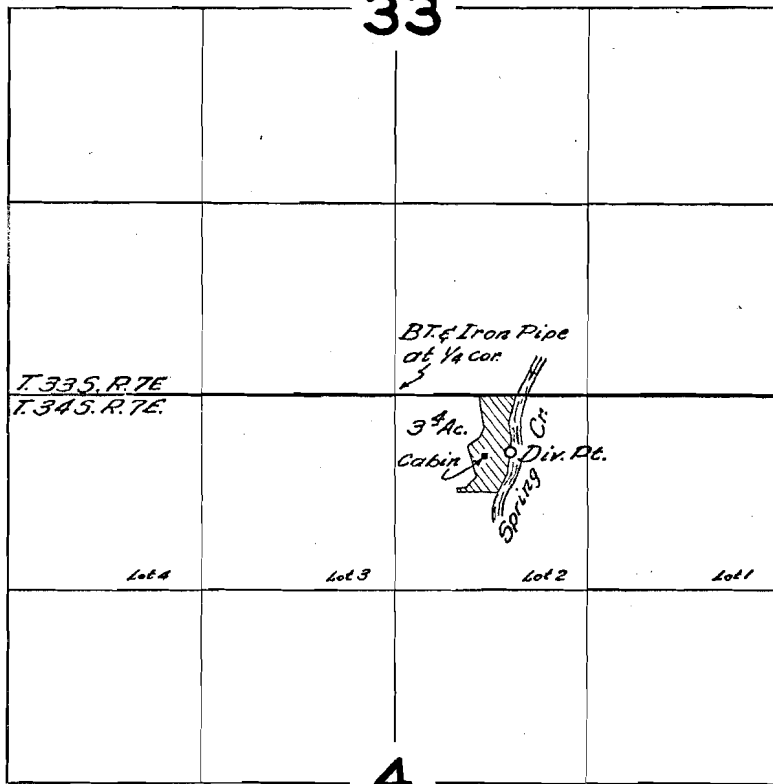

Spring Co. & Mac.

FINAL PROOF SURVEY UNDER

Application No. 13480... Permit No. 9928...
IN NAME OF

..... W. W. SOUTHWELL

Surveyed May 8 1958, by C.O. Bartels.....