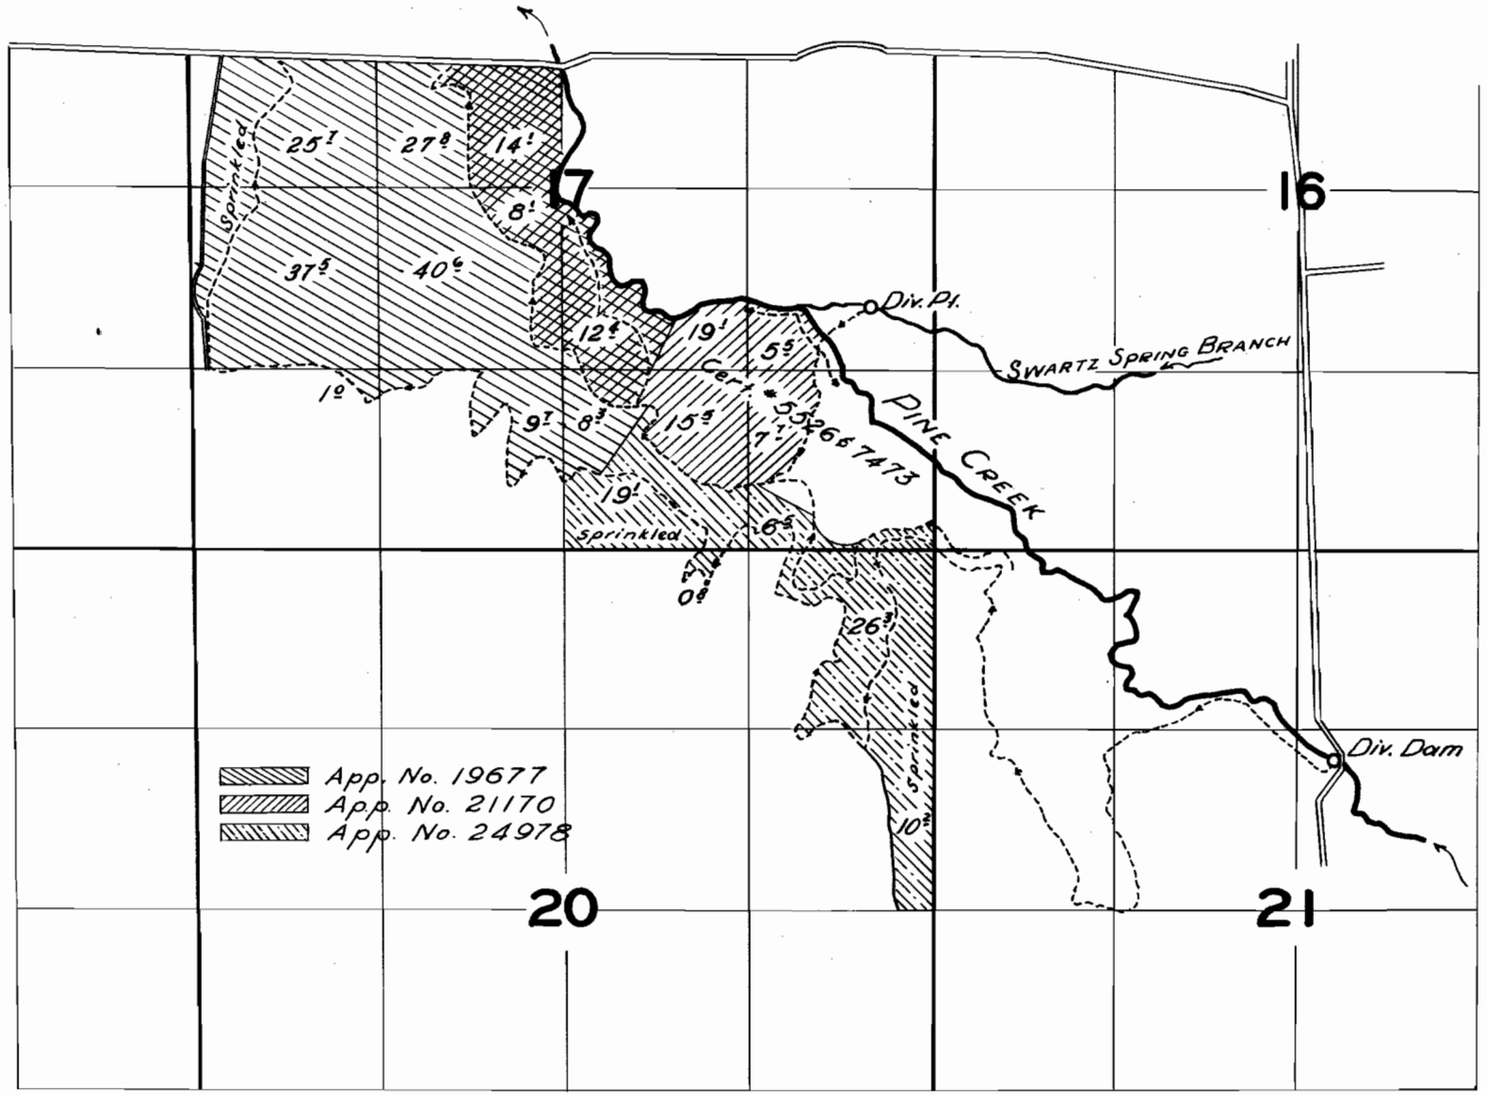

FINAL PROOF SURVEY

In

T.6N.R.34E.W.W.

In Name of

RAYMOND R. BEVANS

Application No. 19677, Permit No. 15257

Application No. 21170, Permit No. 16589

Application No. 24978, Permit No. 19609

Surveyed 3 Nov. 1955 By [illegible]

NZ-5F-111

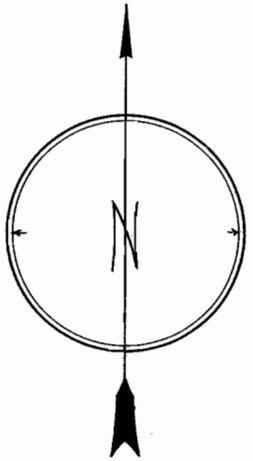

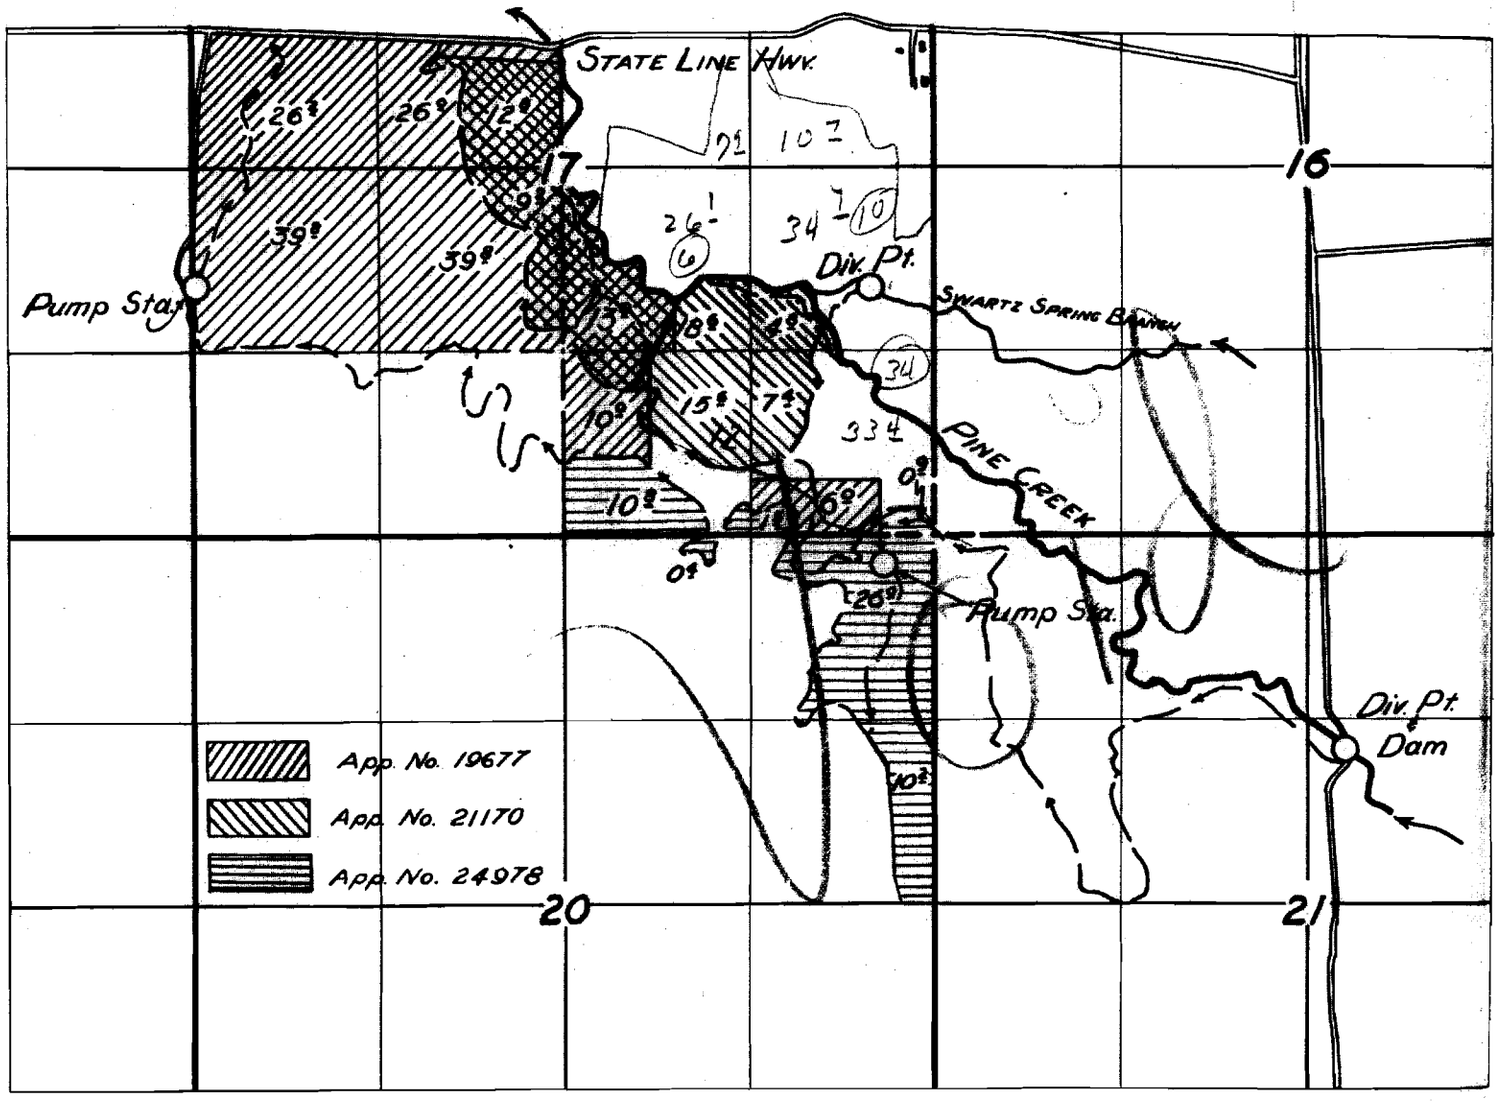

FINAL PROOF SURVEY

In

T. 6 N. R. 34 E. W.M.

In name of

RAYMOND R. BEVANS

Application No. 19677, Permit No. 15257

Application No. 21170, Permit No. 16589

Application No. 24978, Permit No. 19609

Surved 3, Nov, 1955..... By [signature]
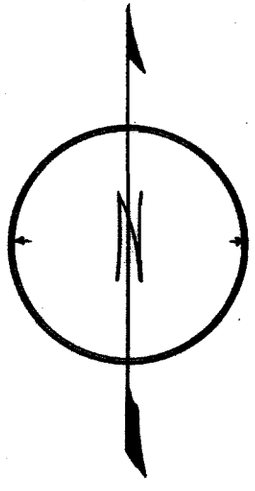
NZ-5F-111