


T. 3S. R. 4E. W.M.

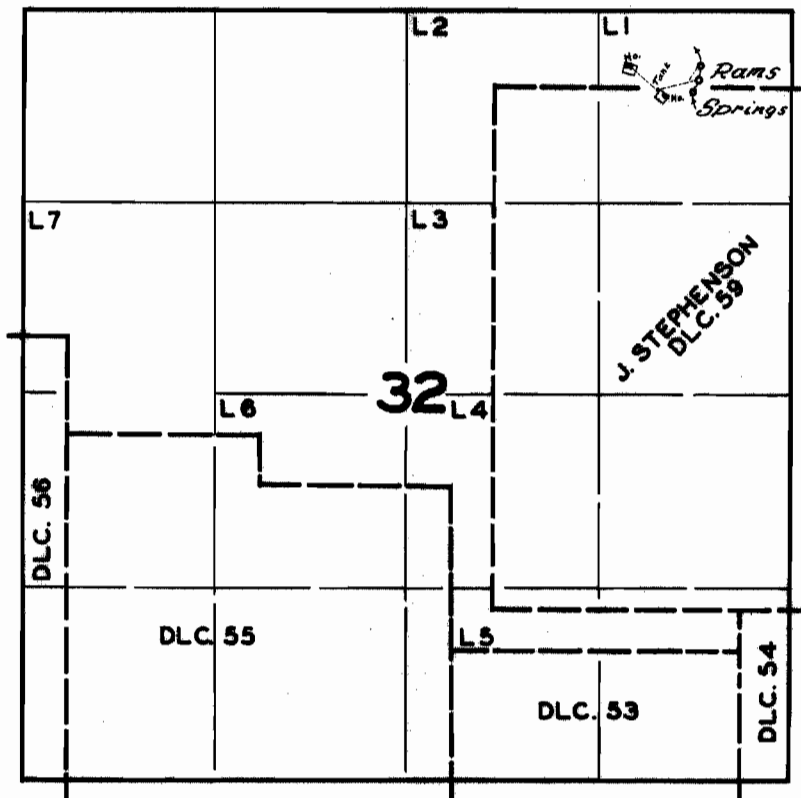

FINAL PROOF SURVEY
UNDER

Application No. 20954 Permit No. 16470
IN NAME OF

Clyde C. Dunlap & Gale Scutt

Surveyed AUG. 22 1957, by *G. C. Scutt*