


T. 8S. R. 3W. W.M.

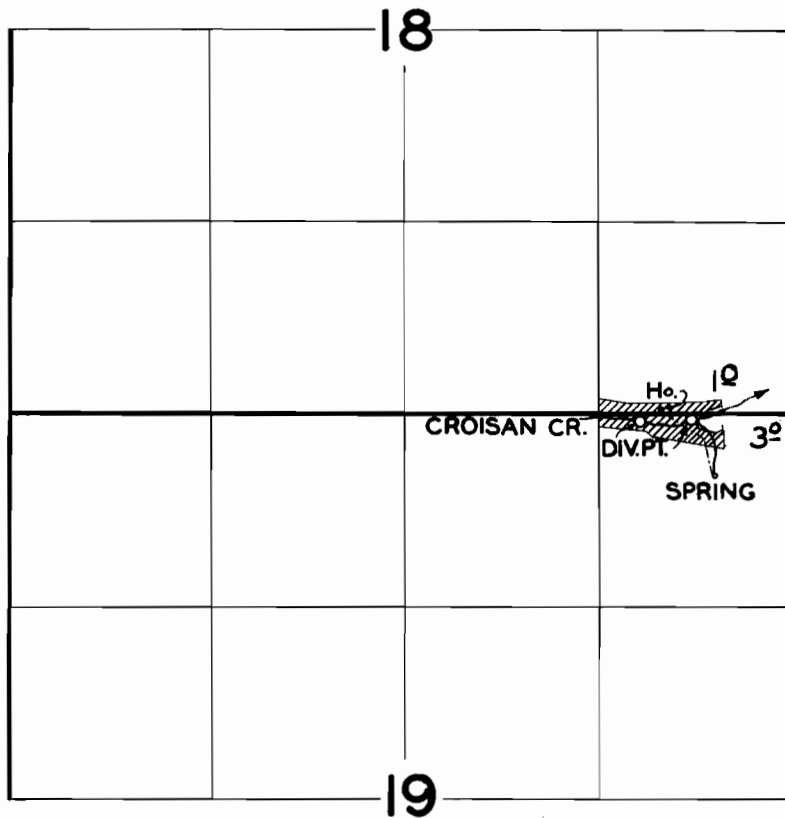

FINAL PROOF SURVEY

UNDER

Application No. 21892 Permit No. 17210

IN NAME OF

W. W. MENDENHALL

Surveyed APR. 4 1957, by *C. O. Bartels*