


T.2&3N.R.9W.W.M.

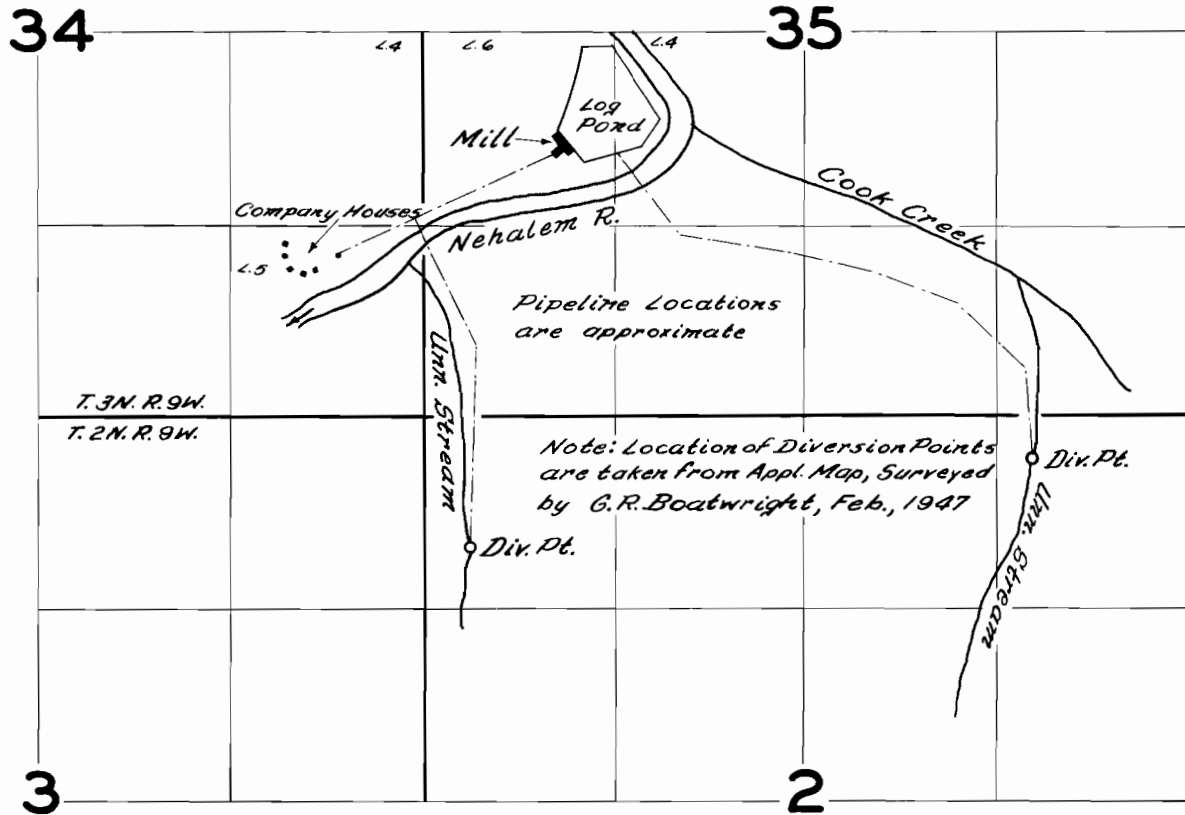

FINAL PROOF SURVEY UNDER

Application No. 22297 Permit No. 17582
22296 17581
IN NAME OF

H.B. & Marie McKenney & Smith & Wright Co.

Surveyed *Sept. 10, 1957*, by *C.Q. Bartels*