


T.2N. R.9W.W.M.

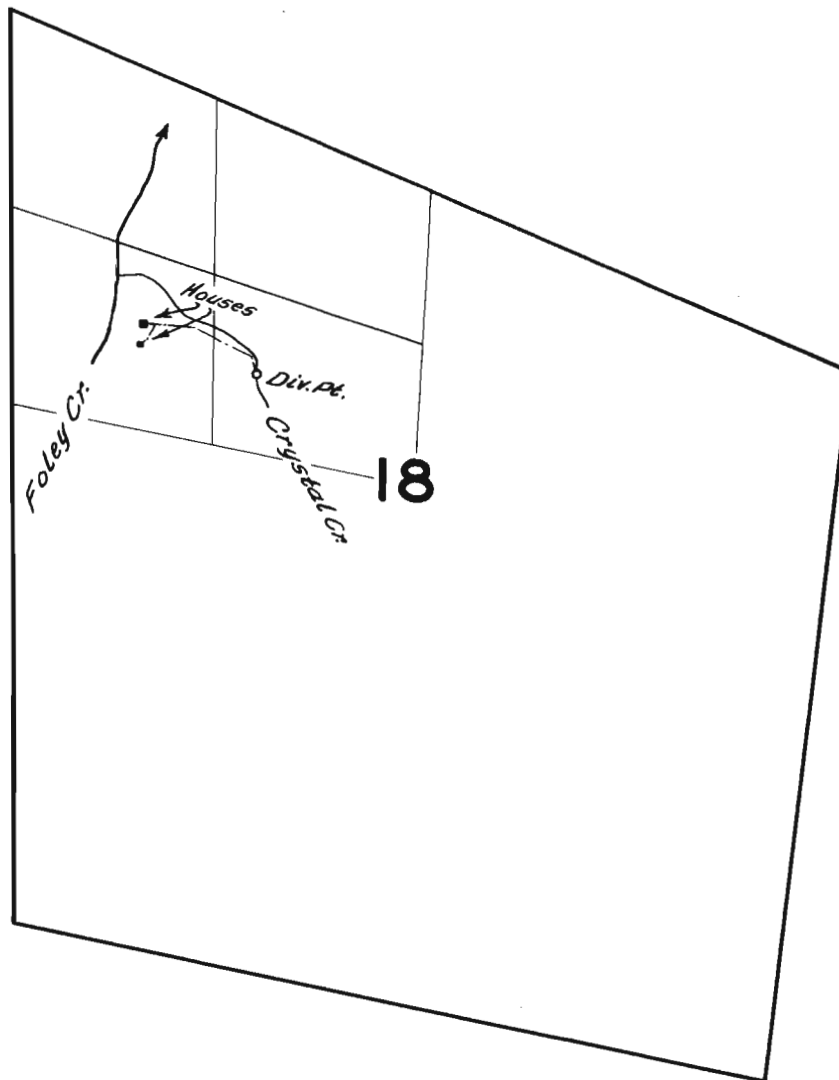

FINAL PROOF SURVEY
UNDER

Application No. 22379 Permit No. 17700
IN NAME OF

Ben Center

Surveyed *Aug 30* 1957, by *C.O. Burt*