


T. 4 S. R. 1 W. W.M.

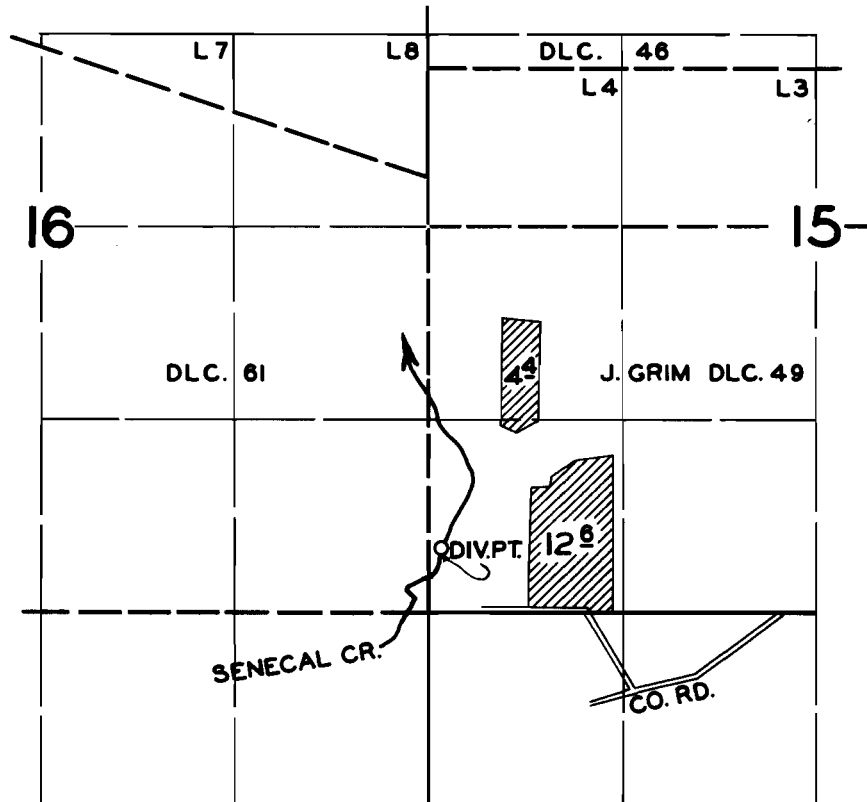

FINAL PROOF SURVEY

UNDER

Application No. 24012 Permit No. 18937

IN NAME OF

*Evert Frederiks*

Surveyed SEPT. 4, 1957, by *C. O. Smith*