


T.3 & 4 S.R.13 E.W.M.

Map reduced 64%

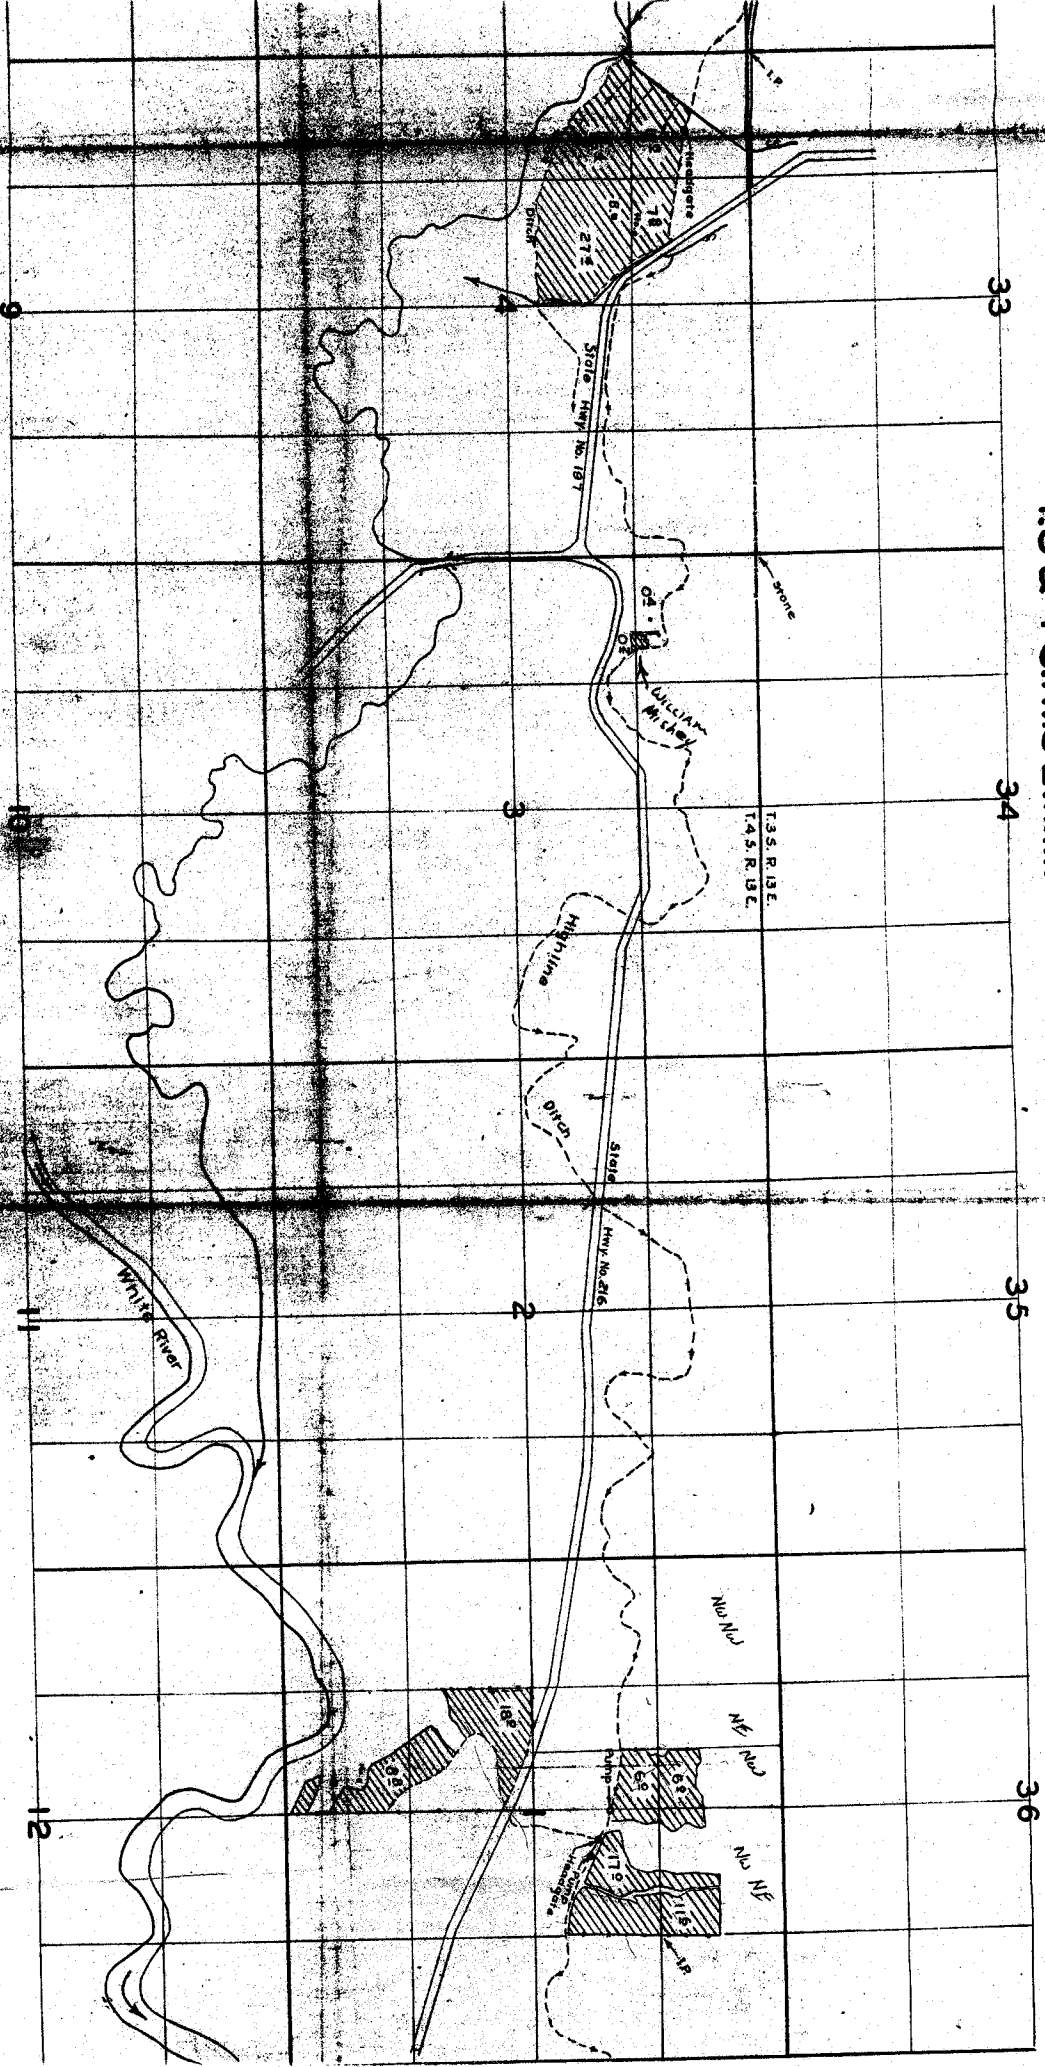

FINAL PROOF SURVEY

UNDER

Application No. 24230 Permit No. 19066

IN NAME OF

Tygh Valley Highline Ditch Co.

Surveyed 18 Oct. 1952, by Wm. R. Bell