


# T24SR5WWM

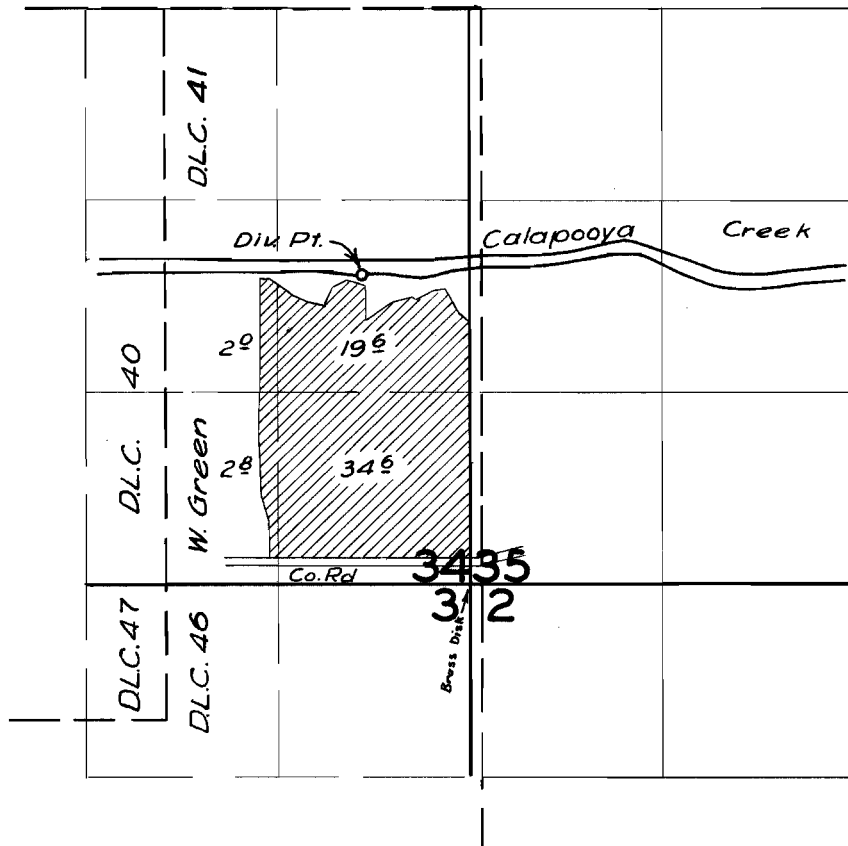

## FINAL PROOF SURVEY UNDER

Application No. 25295 Permit No. 19857  
IN NAME OF

L. T. Howard

Surveyed Aug. 19 1957, by M. Bish