


T.13S. R.10W. W.M.

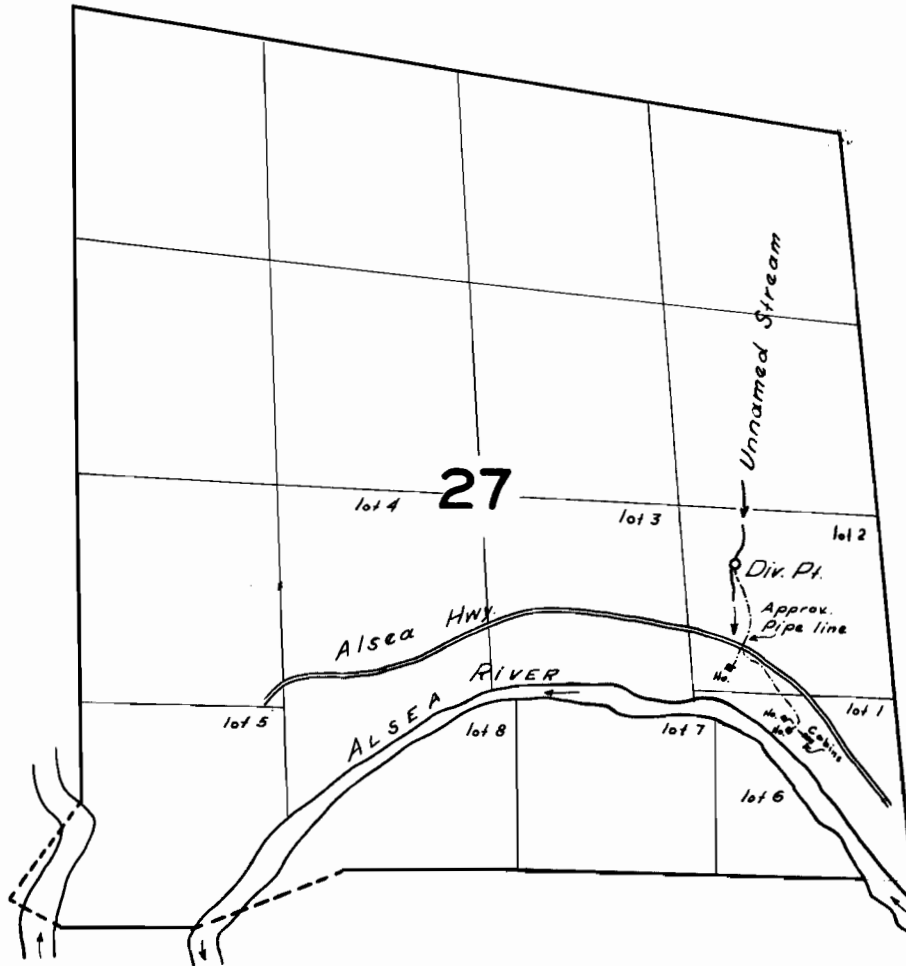

FINAL PROOF SURVEY
UNDER

Application No. 24400 Permit No. 20187
IN NAME OF

Mrs Guy A. Cox & Marvin B. & Eval. Noble

Surveyed 17 June 1957, by [Signature]