


T 23 S. R. 5 W WM

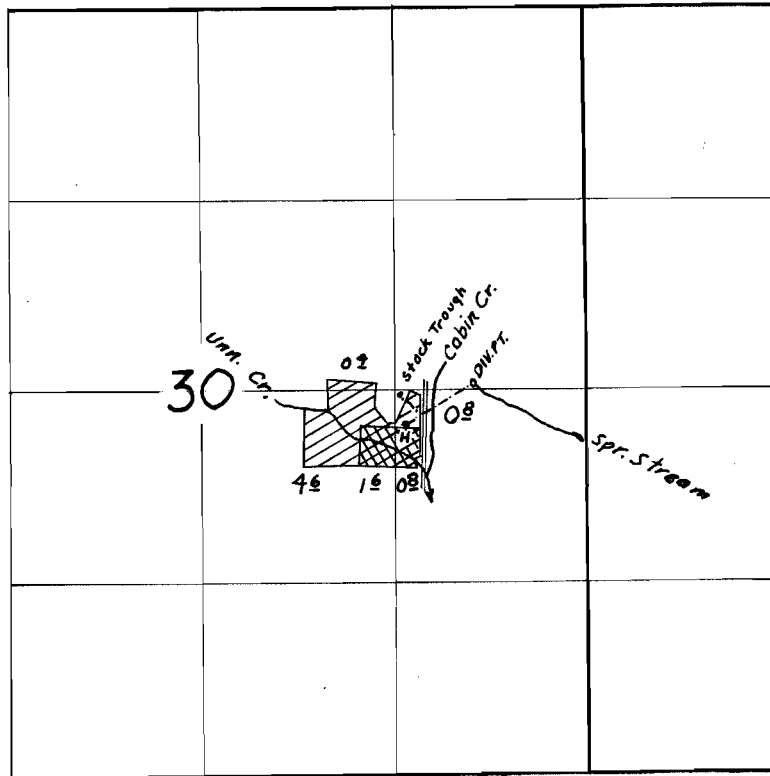

**FINAL PROOF SURVEY**  
UNDER

Application No. 26400 Permit No. 20710  
IN NAME OF

Fred H & Florence Cogswell

Surveyed July 3 1956, by C.O. Bartels